

*California Department of Transportation  
Division of Maintenance  
Structure Maintenance and Investigations*

---

**B**<sub>ridge</sub>

**I**<sub>nspection</sub>

**R**<sub>ecords</sub>

**I**<sub>nformation</sub>

**S**<sub>ystem</sub>

---



The requested documents have been generated by BIRIS.

These documents are the property of the California Department of Transportation and should be handled in accordance with Deputy Directive 55 and the State Administrative Manual.

Records for “Confidential” bridges may only be released outside the Department of Transportation upon the execution of a confidentiality agreement.



DIST.	COUNTY	ROUTE	POST MILES-TOTAL PROJECT	SHEET NO.	DATE
CL	Hum	101	R51.5/R53.9	129	10-7-76

ENGINEER: *John F. Schroeder*  
 REGISTERED CIVIL ENGINEER NUMBER: 5678  
 ASSISTANT STATE HIGHWAY ENGINEER  
 REGISTERED CIVIL ENGINEER NUMBER: 1088  
 DATE APPROVED: November 19, 1976

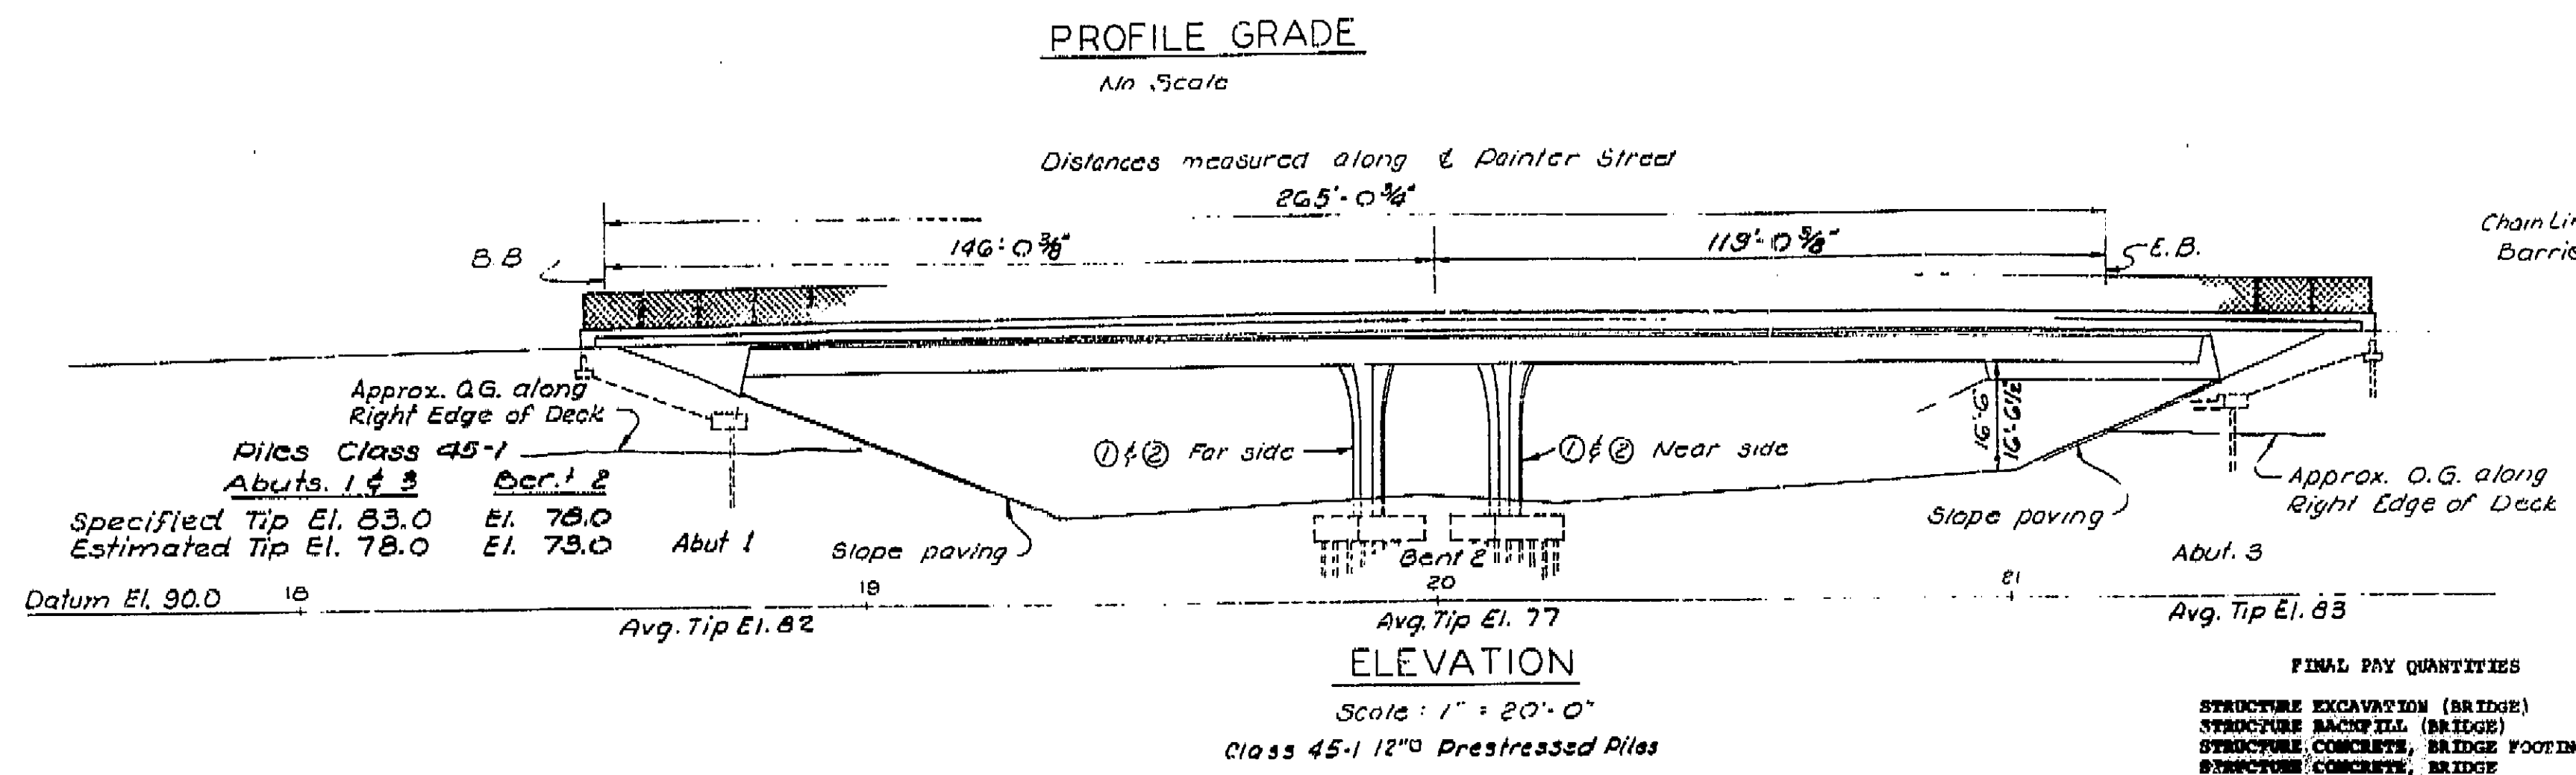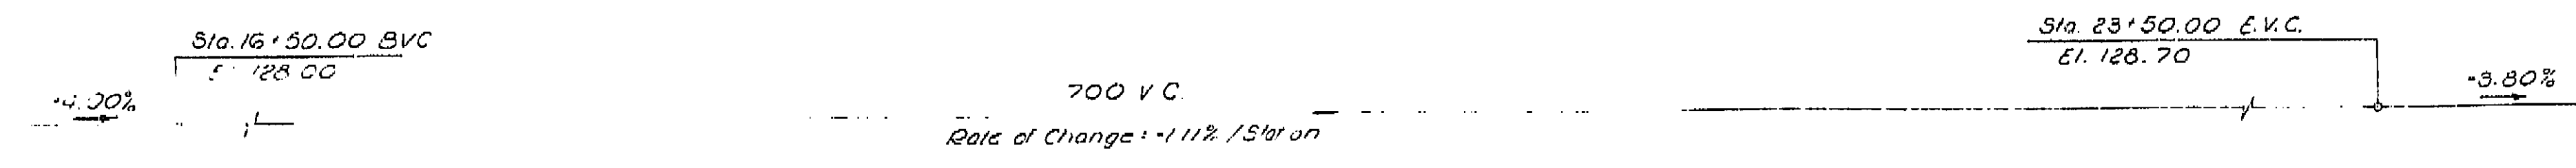

**FINAL PAY QUANTITIES**

STRUCTURE EXCAVATION (BRIDGE)	340 CY
STRUCTURE BACKFILL (BRIDGE)	175 CY
STRUCTURE CONCRETE, BRIDGE FOOTING	88 CY
STRUCTURE CONCRETE, BRIDGE	230 CY
CAST-IN-PLACE PRESTRESSED CONCRETE (GRADE 35-50)	1,025 CY
BAR REINFORCING STEEL (BRIDGE)	225,000 LB

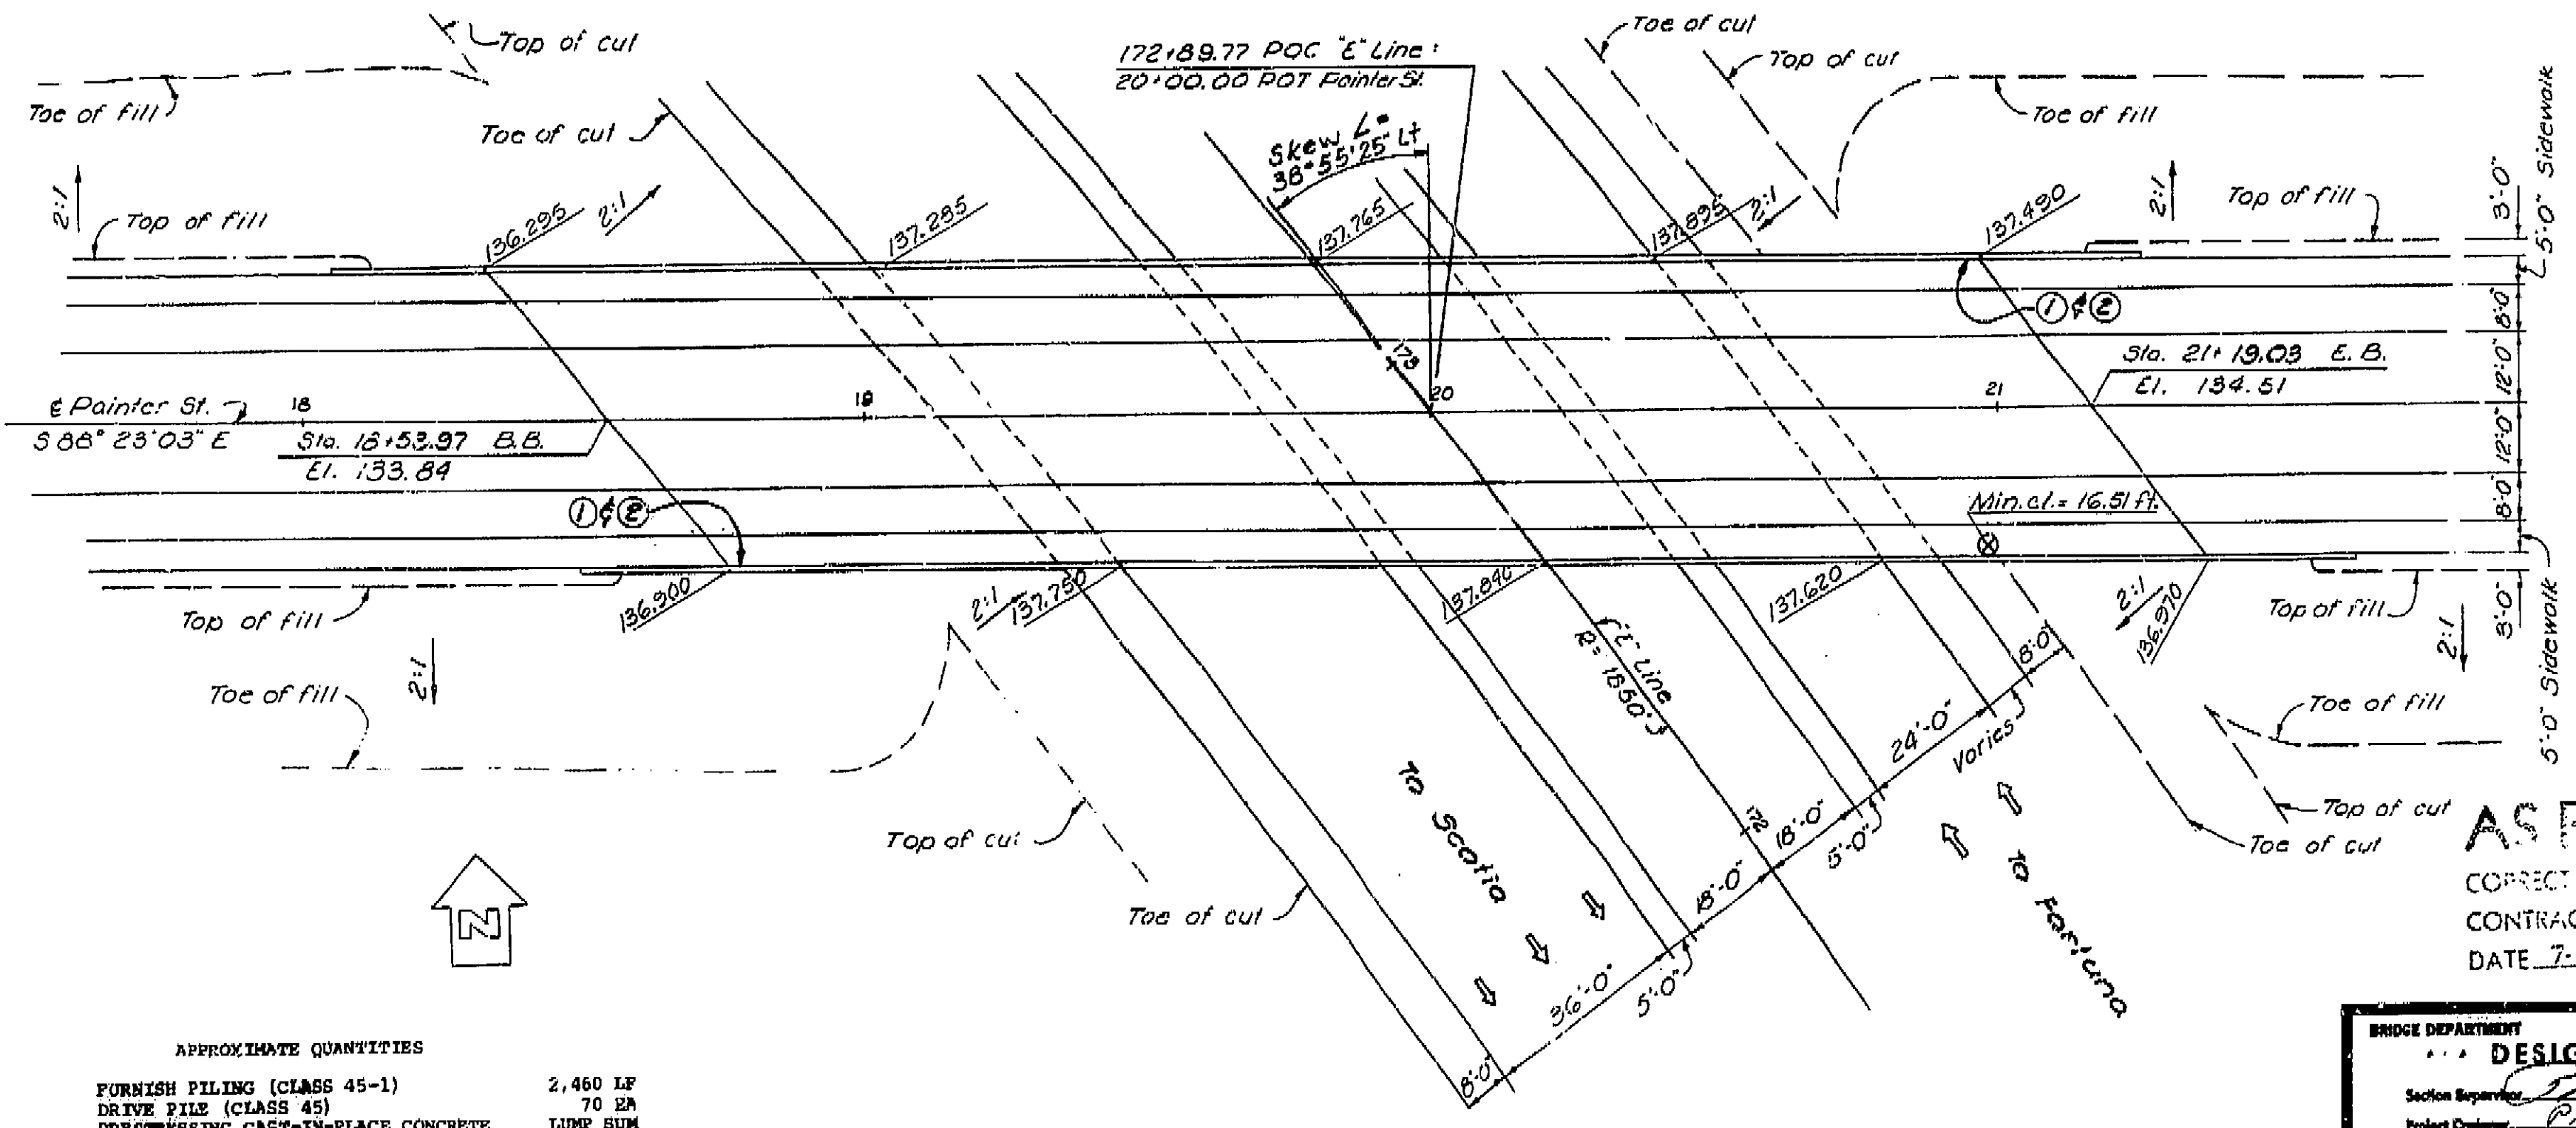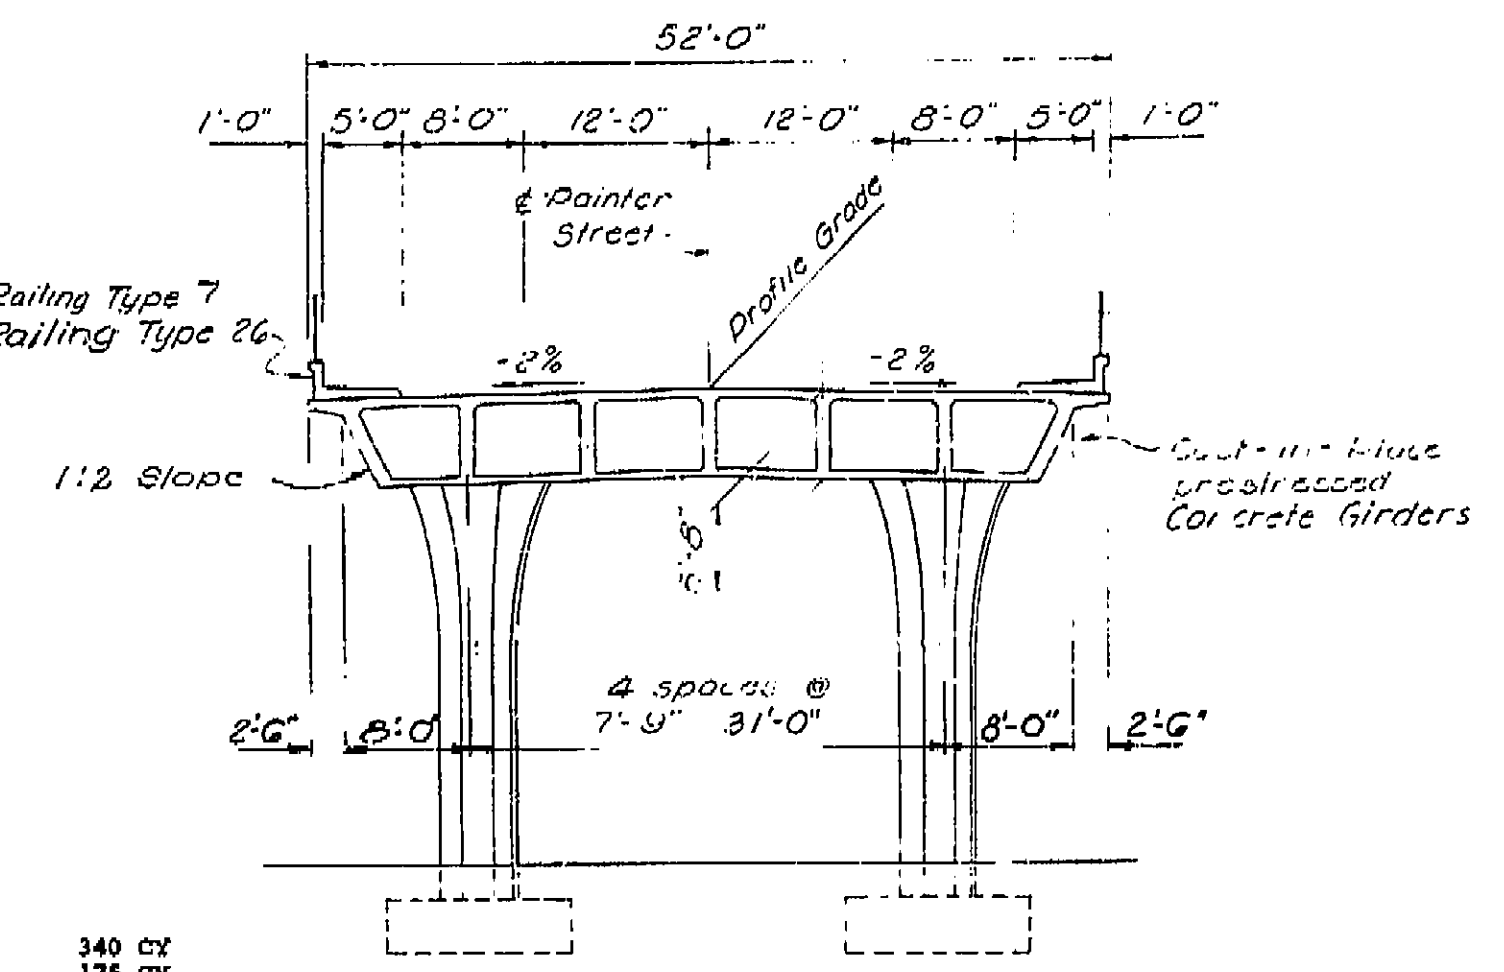

**INDEX TO PLANS**

Sheet No.	Title
1	General Plan
2	Deck Contours
3	Foundation Plans
4	Abutment Details
5	Bent 2 Details
6	Typical Section
7	Girder Layout
8	Simple Beam Wingwall Details
9	Slope Paving Details - Full Slope
10	Log of Test Borings

**STANDARD PLANS DATED JANUARY, 1973**

A62-B8	EXCAVATION AND BACKFILL BRIDGE LIMITS OF PAYMENT
B0-1	BRIDGE DETAILS (GENERAL & ABUTMENT)
B0-3	BRIDGE DETAILS (WALLS)
B0-5	BRIDGE DETAILS (DECK)
B2-1	PILE DETAILS - CLASS 45-1 & CLASS 45-2
B7-1	BOX GIRDER DETAILS
B8-5	CAST-IN-PLACE PRESTRESSED GIRDER DETAILS
B11-52	CHAIN LINK RAILING TYPE 7
B11-54	BARRIER RAILING TYPE 26

**AS BUILT**  
 CORRECTED BY J.A. Schroeder  
 CONTRACT NO. 01-061224  
 DATE 7-23-76 R.T. 4-1-77

**APPROXIMATE QUANTITIES**

FURNISH PILING (CLASS 45-1)	2,460 LF
DRIVE PILE (CLASS 45)	70 EA
PRESTRESSING CAST-IN-PLACE CONCRETE	LUMP SUM
WATERSTOP	35 LF
STRIP WATERSTOP	60 LF
8" PERFORATED STEEL PIPE UNDERDRAIN (.064" THICK)	116 LF
CLASS 1 PERMEABLE MATERIAL (BRIDGE)	30 CY
8" CORRUGATED STEEL PIPE DOWNDRAIN (.064" THICK)	92 LF
SLOPE PAVING (CONCRETE)	69 CY
CHAIN LINK RAILING (TYPE 7)	635 LF

**PLAN**  
 Scale: 1" = 20'-0"

**AS BUILT PLANS**  
 Contract No. 01-061224  
 Date Completed  
 Document No. 1000 2617

- ⊗ Point of minimum vertical clearance.
  - ① Point "Bridge No. 4-236" & year constructed.
  - ② Point "Painter Street Overcrossing".
- FOR GENERAL NOTES SEE "Deck Contours" sheet

**BRIDGE DEPARTMENT**

**DESIGN SECTION 6**

Section Designer: *John F. Schroeder*  
 Project Designer: *John F. Schroeder*  
 Project Number: 10-73

DESIGN	By <i>John F. Schroeder</i>	Check <i>John F. Schroeder</i>
DETAILS	By <i>John F. Schroeder</i>	Check <i>John F. Schroeder</i>
LAYOUT	By <i>John F. Schroeder</i>	Check <i>John F. Schroeder</i>
QUANTITIES	By <i>John F. Schroeder</i>	Check <i>John F. Schroeder</i>
SPECIFICATIONS	By <i>John F. Schroeder</i>	Check <i>John F. Schroeder</i>

Approval: *John F. Schroeder* 7289

**STATE OF CALIFORNIA**  
**DEPARTMENT OF TRANSPORTATION**

**PAINTER STREET OVERCROSSING**  
 LOCATED IN THE CITY OF RIO DELL IN HUMBOLDT COUNTY

**GENERAL PLAN**


BRIDGE NO.	04-236	POST MILES	53.2	DRAWING NO.	04236-1	SHEET	1	OF	10
------------	--------	------------	------	-------------	---------	-------	---	----	----

I HEREBY CERTIFY THAT THIS IS A TRUE AND ACCURATE COPY OF THE ABOVE DOCUMENT TAKEN UNDER MY DIRECTION AND CONTROL ON THIS DATE IN SACRAMENTO, CALIFORNIA PURSUANT TO AUTHORIZATION BY THE DIRECTOR OF TRANSPORTATION.


DATE: 10-6-78  
 SIGNATURE: *Joseph M. Smith*  
 TITLE: *Supervisor of Mapping*

129  
 MICROFILMED  
 OCT 1978





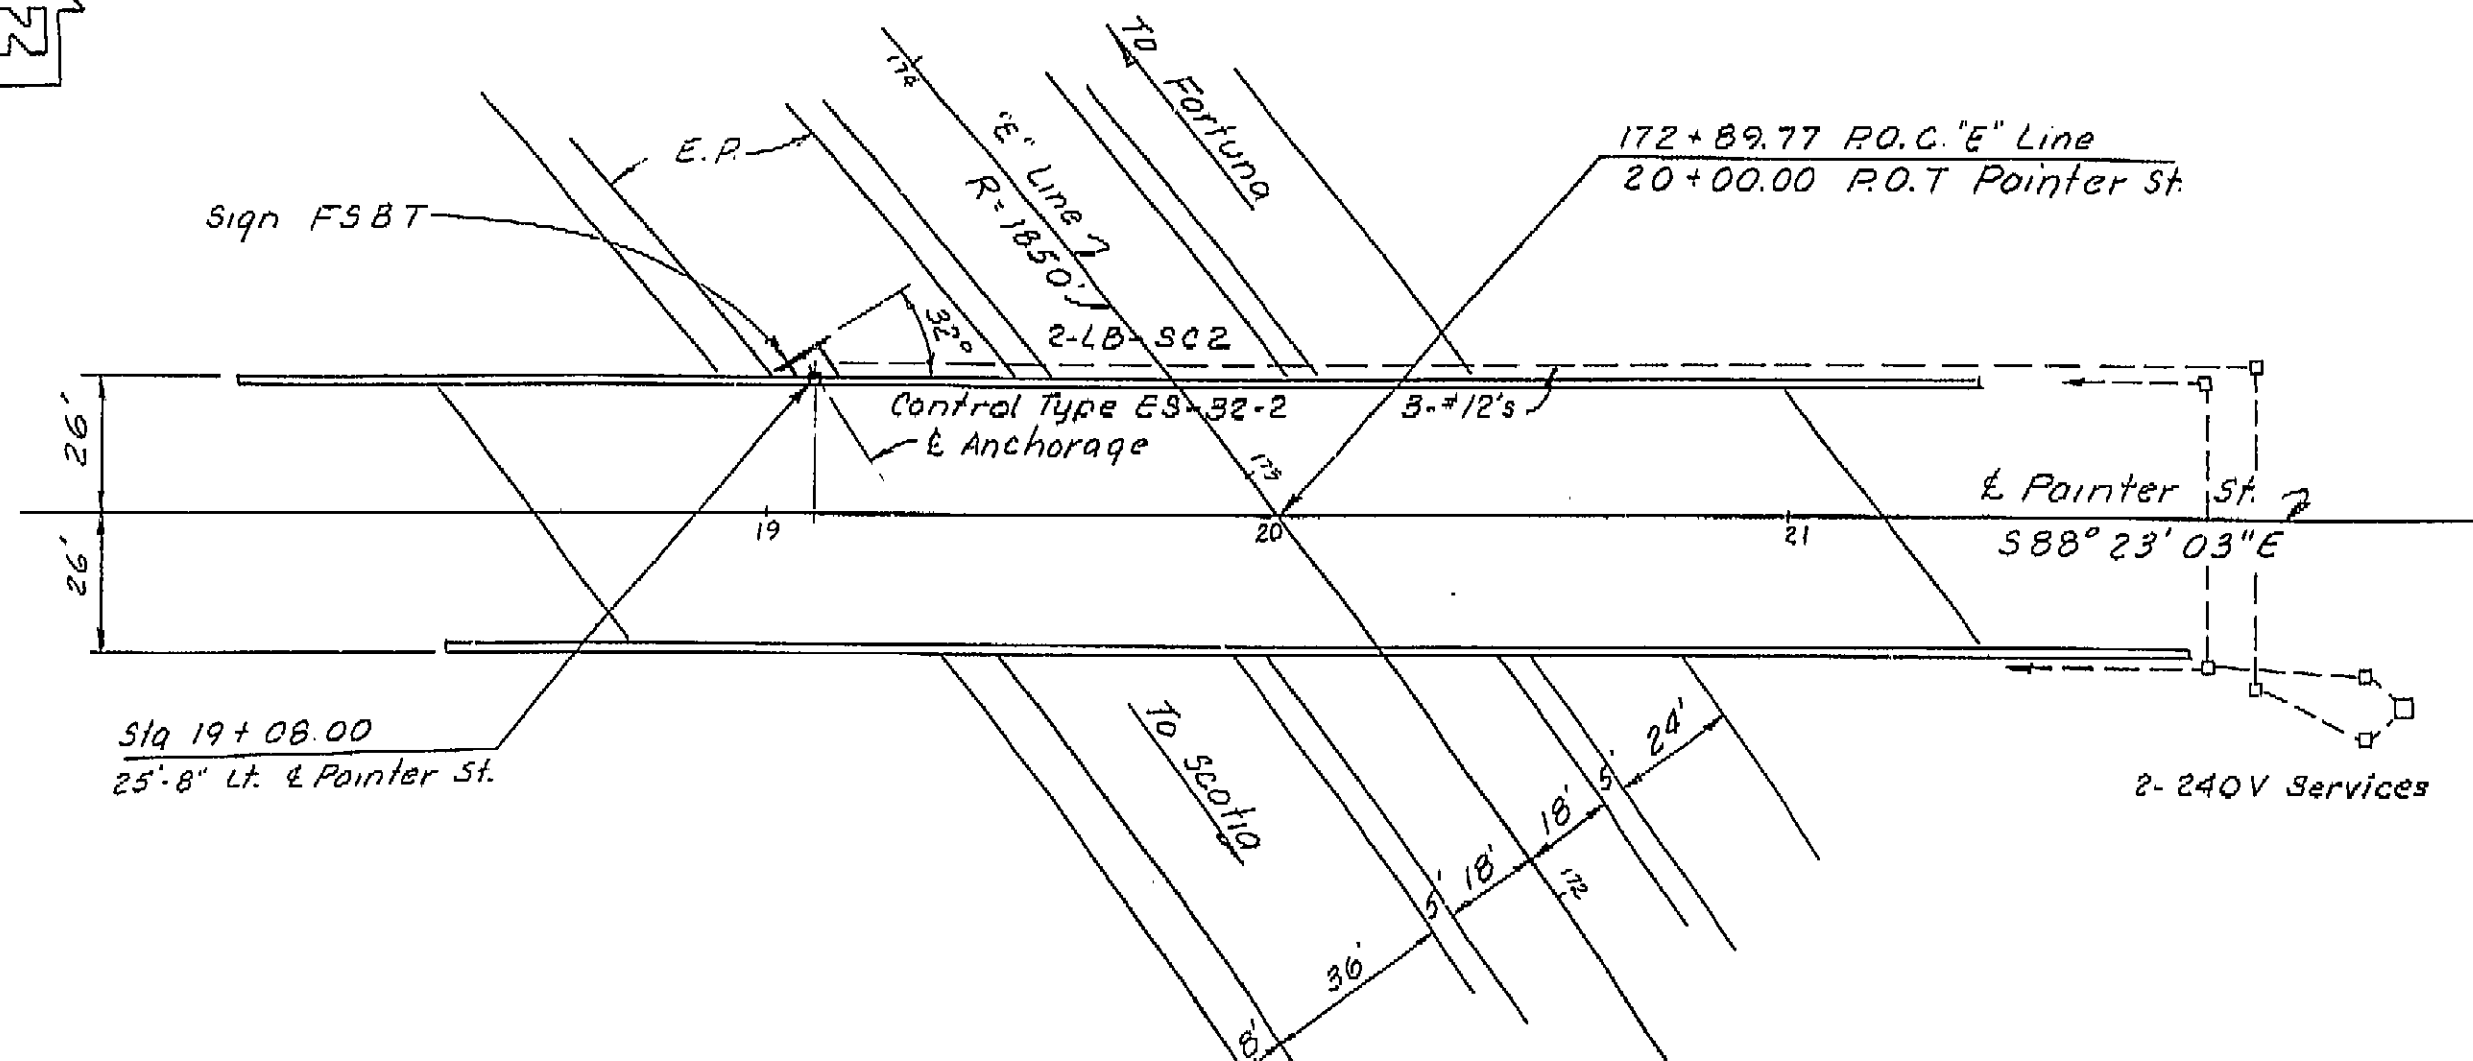

Top of sign parallel to deck

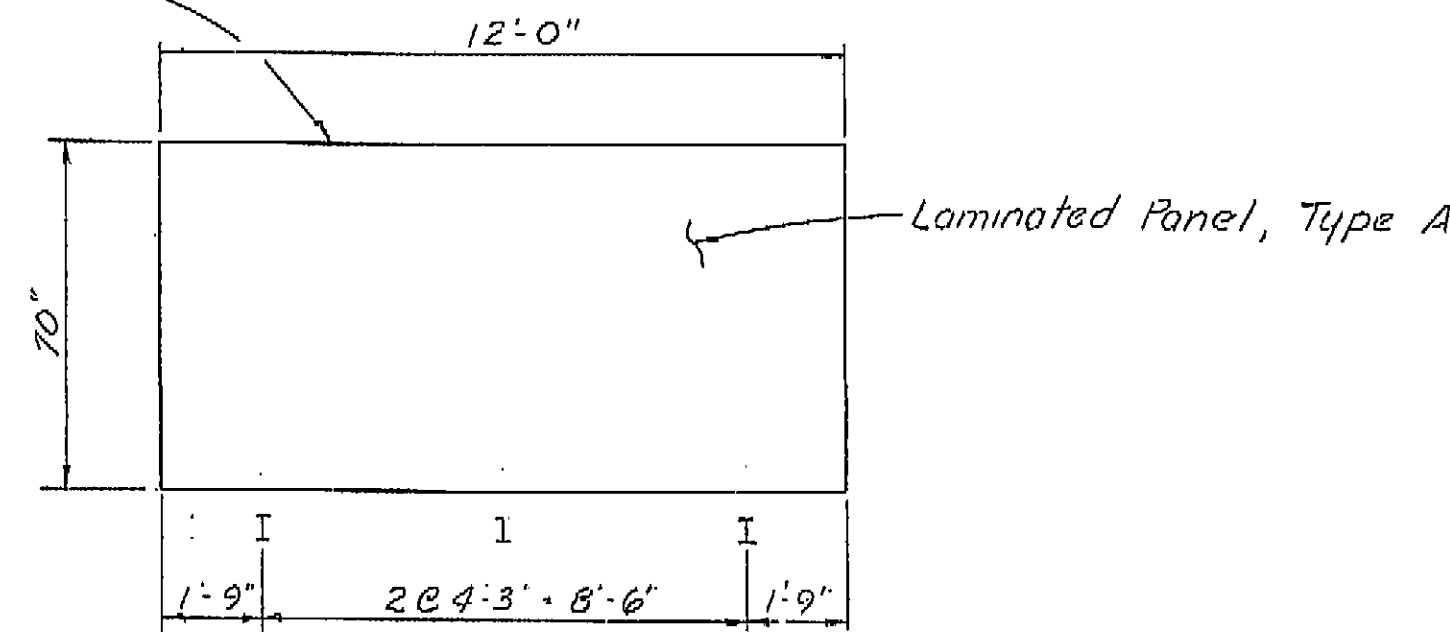

WALKWAY BRACKET SPACING

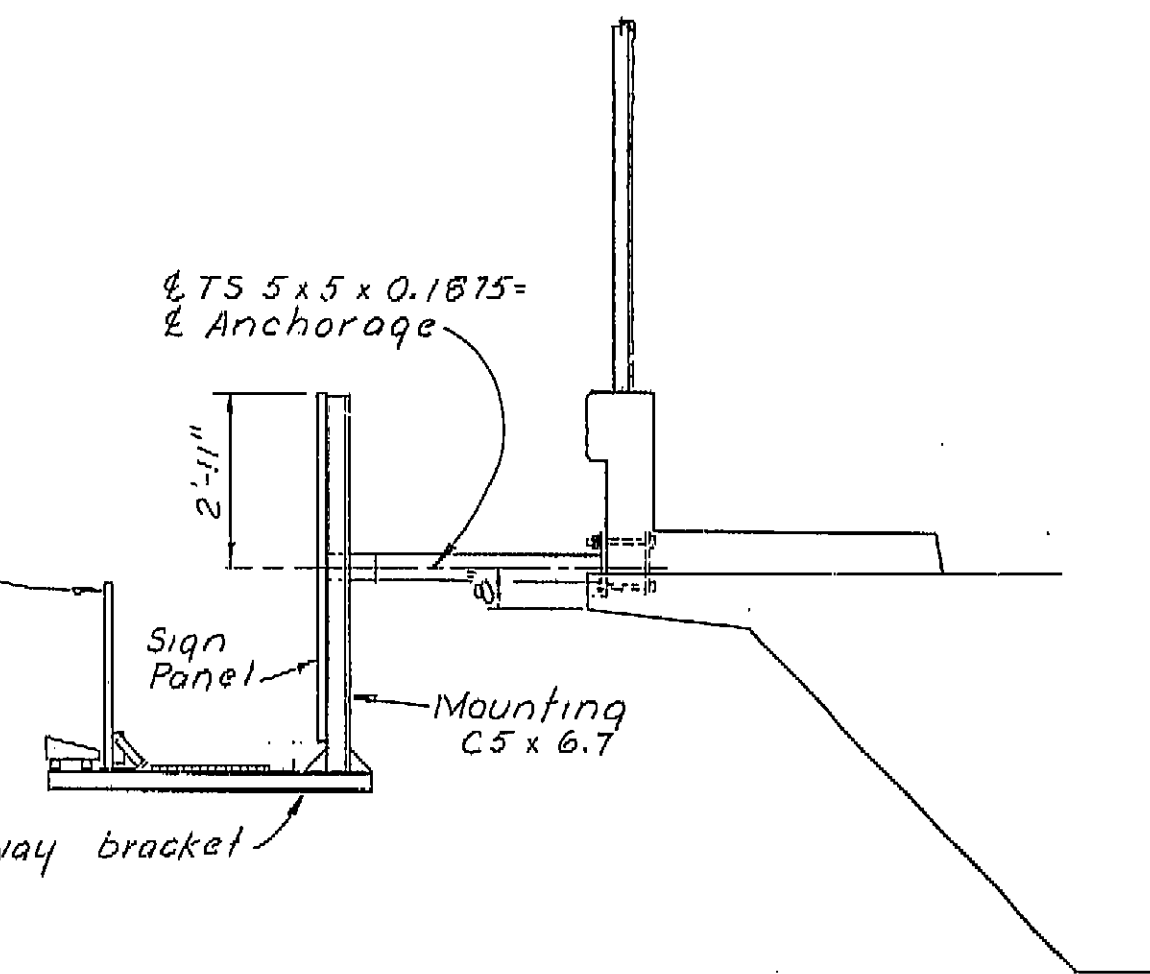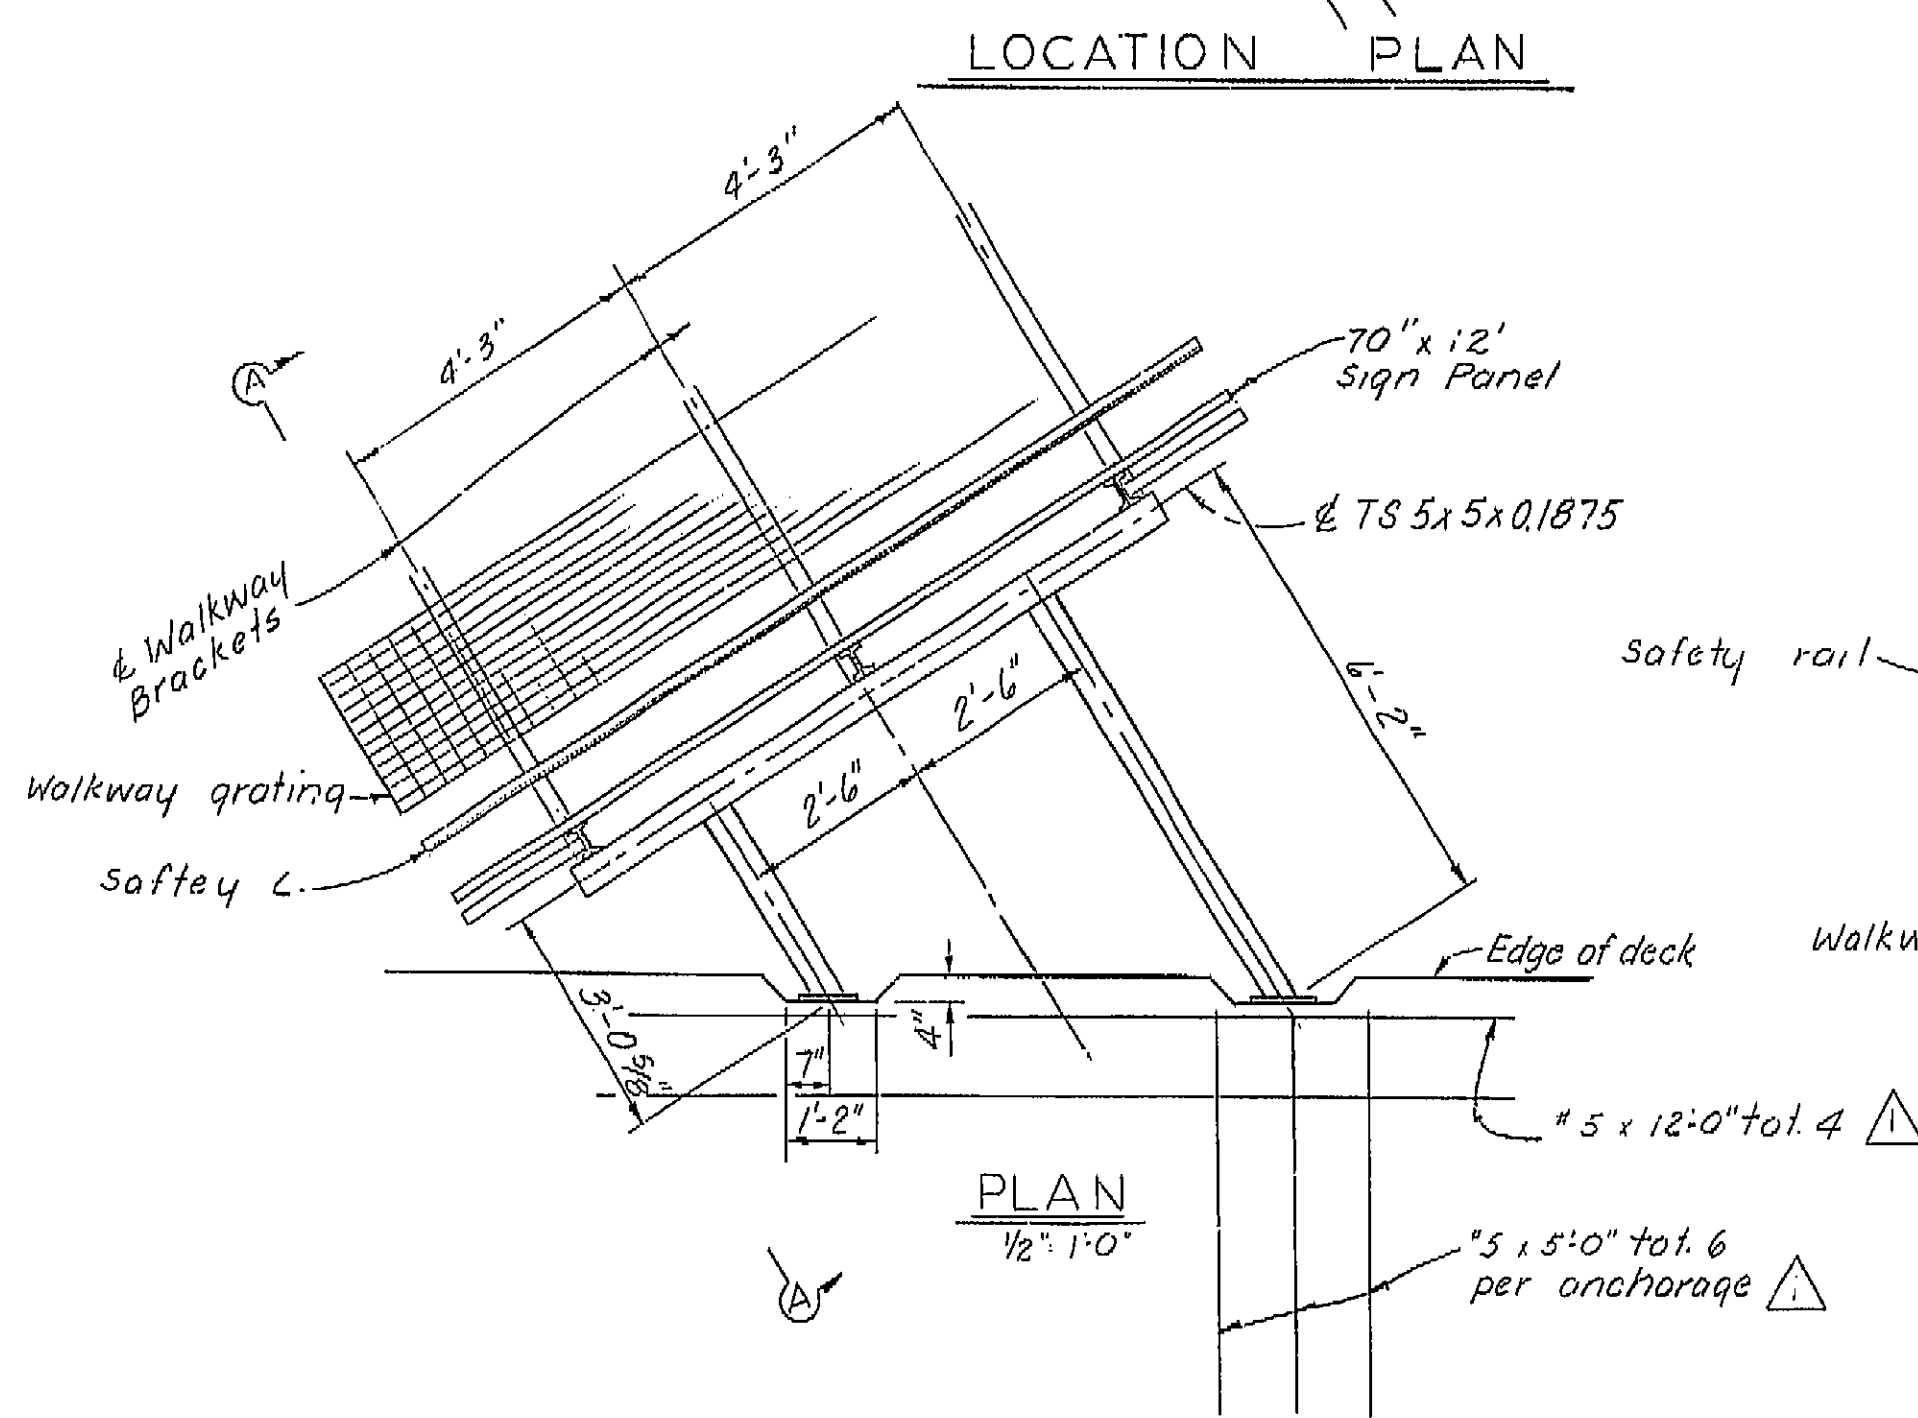

SECTION A-A  
9/8" = 1'-0"

**AS BUILT PLANS**  
Contract No. 01-061224  
Date Completed 8/74  
Document No. 1000-2612

MARK	DATE	DESCRIPTION	BY	CHK'D
Δ	9/3/70	Additional reinf of anchorage	Tm	Lrv
Δ				
Δ				
Δ				

**AS BUILT**

CORRECTIONS BY L.A. Schroeder  
CONTRACT NO. 01-061224  
DATE 8-2-76 R.T. 4-1-77


**INDEX TO PLANS**

Sht. no.	Title
1.	Bridge Mounted Sign
2.	Mounting Details

CONTRACT CHANGE ORDER NO. 27  
SHEET 2 OF 2

DESIGN	By <u>R.C. Johnson</u> 6-74	Checked <u>T.J. Harrington</u> 7/74	BRIDGE DEPARTMENT	BRIDGE NO. <u>4-236</u>	PAINTER STREET OVERCROSSING
DETAILS	By <u>Ben M. Mott</u> 5/74	Checked <u>T.J. Harrington</u> 7/74	DESIGN SECTION <b>12</b>	POST MILE <u>53.2</u>	
QUANTITIES	By <u>Wm.</u> 8/74	Checked <u>Ben Mott</u> 8/74	PROJECT ENGINEER <u>R.C. Johnson</u>		BRIDGE MOUNTED SIGN
ORIGINAL SCALE IN INCHES FOR REDUCED PLANS			CU <u>01502</u> WO <u>061223</u>	Disregard prints bearing earlier revision dates	SHEET <u>1</u> OF <u>2</u>


I HEREBY CERTIFY THAT THIS IS A TRUE AND ACCURATE COPY OF THE ABOVE DOCUMENT TAKEN UNDER MY DIRECTION AND CONTROL ON THIS DATE IN SACRAMENTO, CALIFORNIA PURSUANT TO AUTHORIZATION BY THE DIRECTOR OF TRANSPORTATION.  
DATE 4/14/77 BY Joseph M. Guter TITLE Supervisor

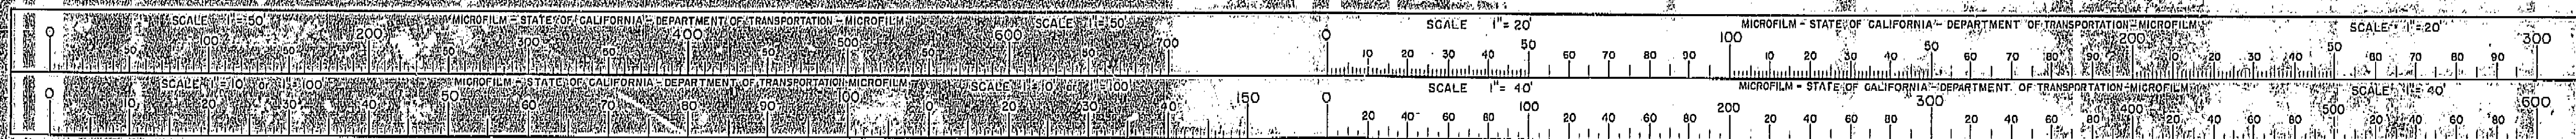











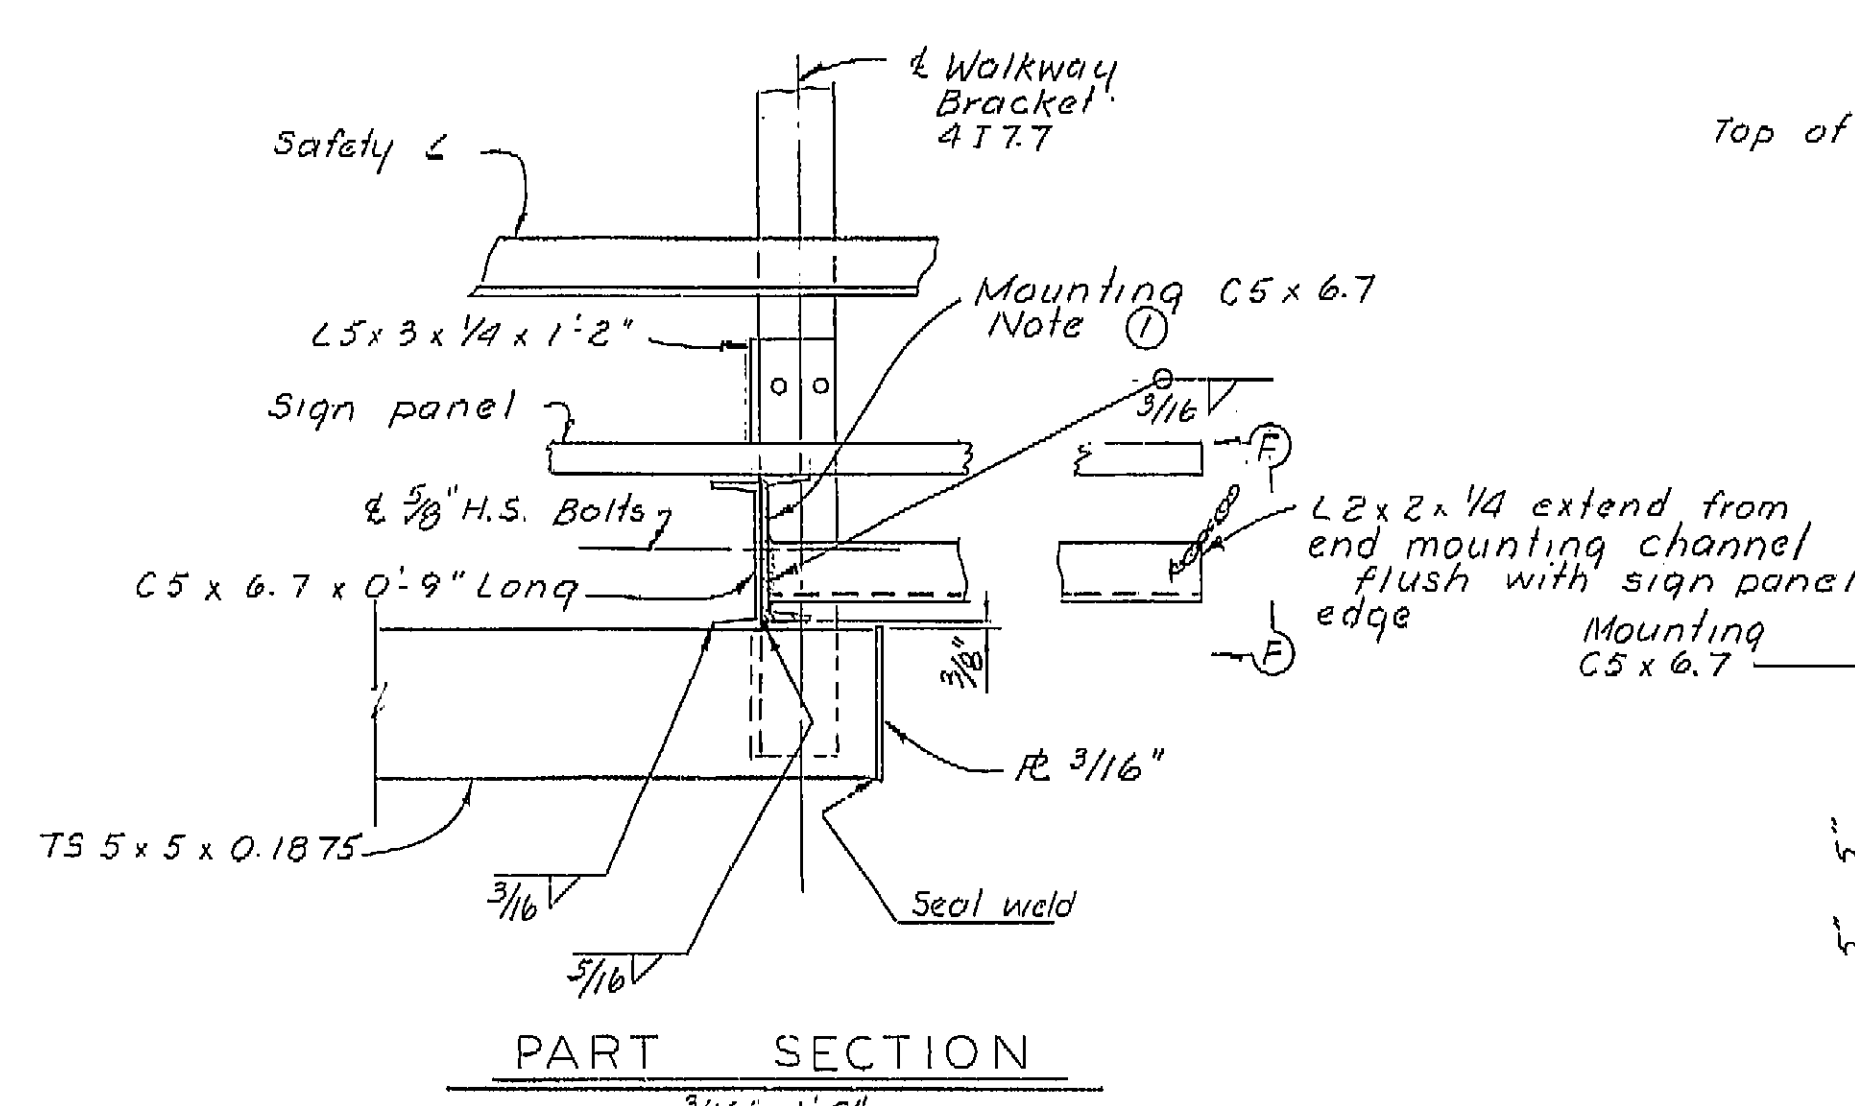

- Note:
- Exterior mounting channel shown interior similar except as noted.
  - The exterior mounting channel face outward to accommodate the walkway chain angle.
  - For details not shown see "Standard Plans".

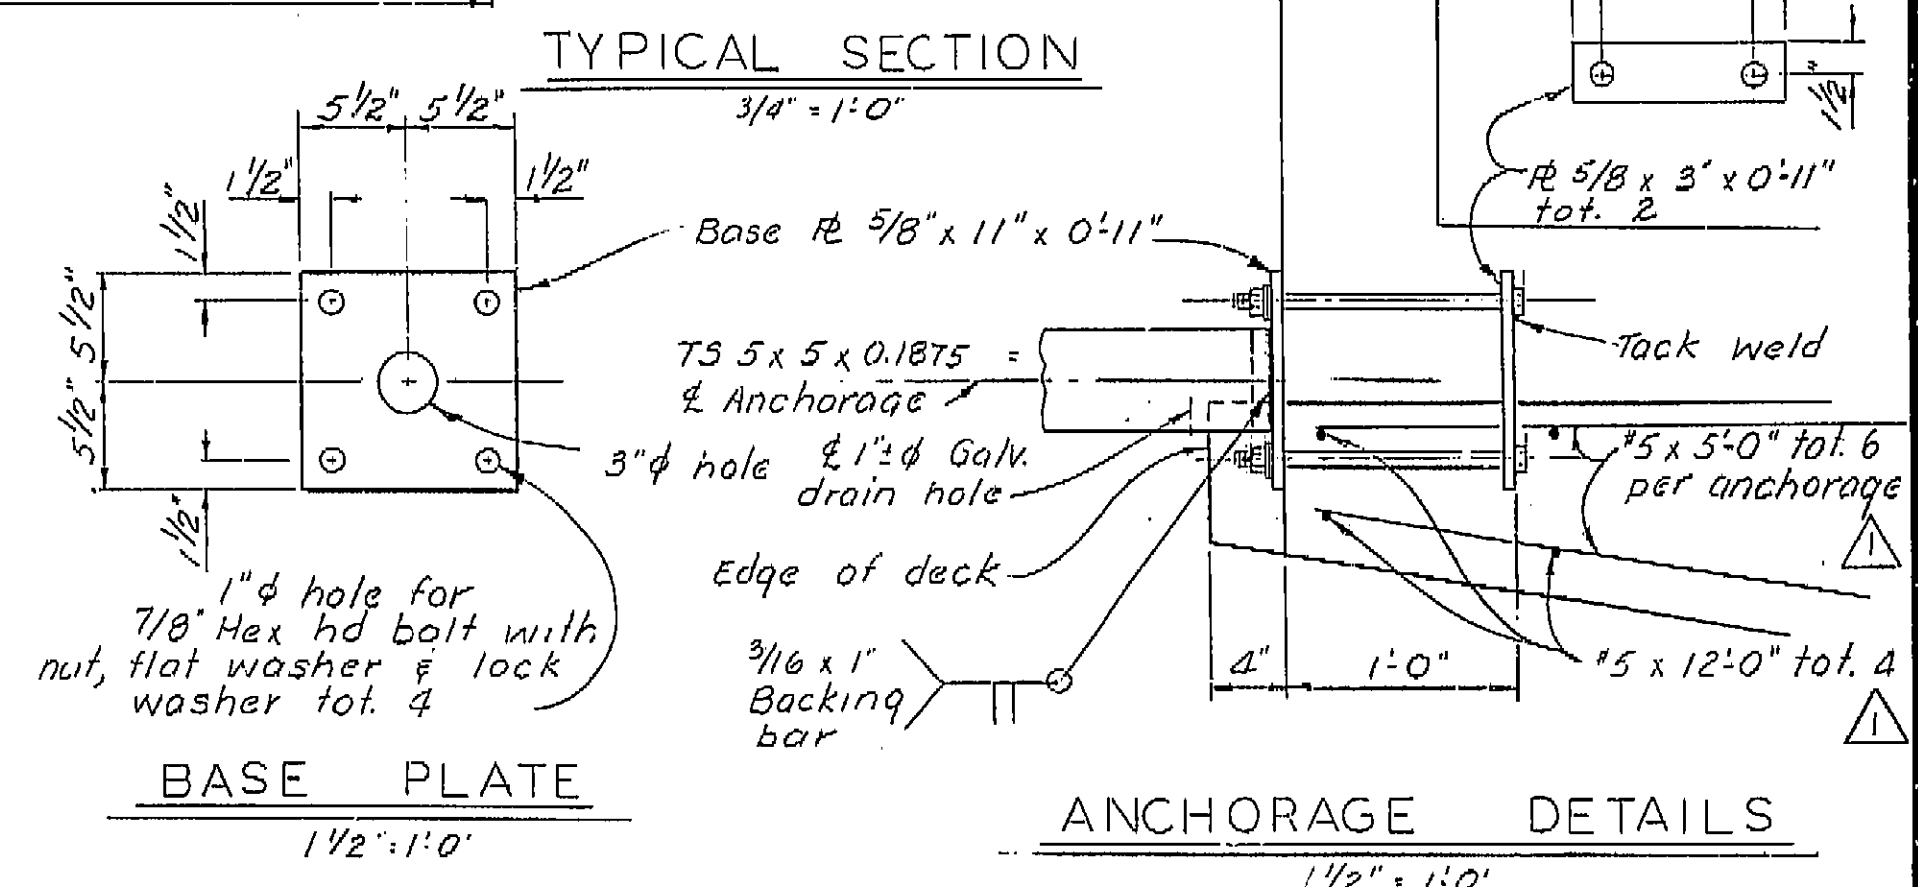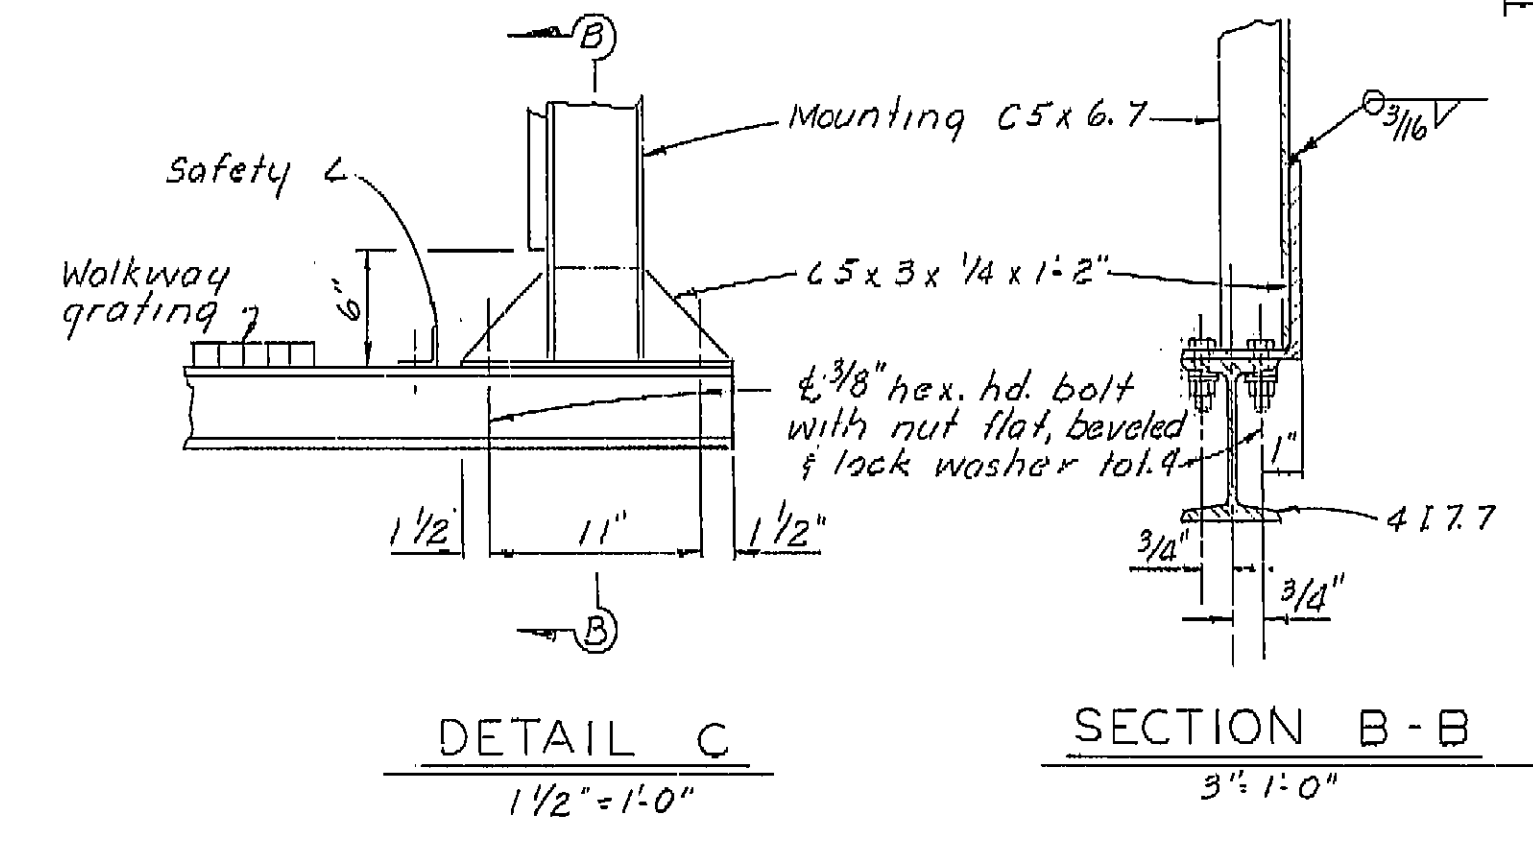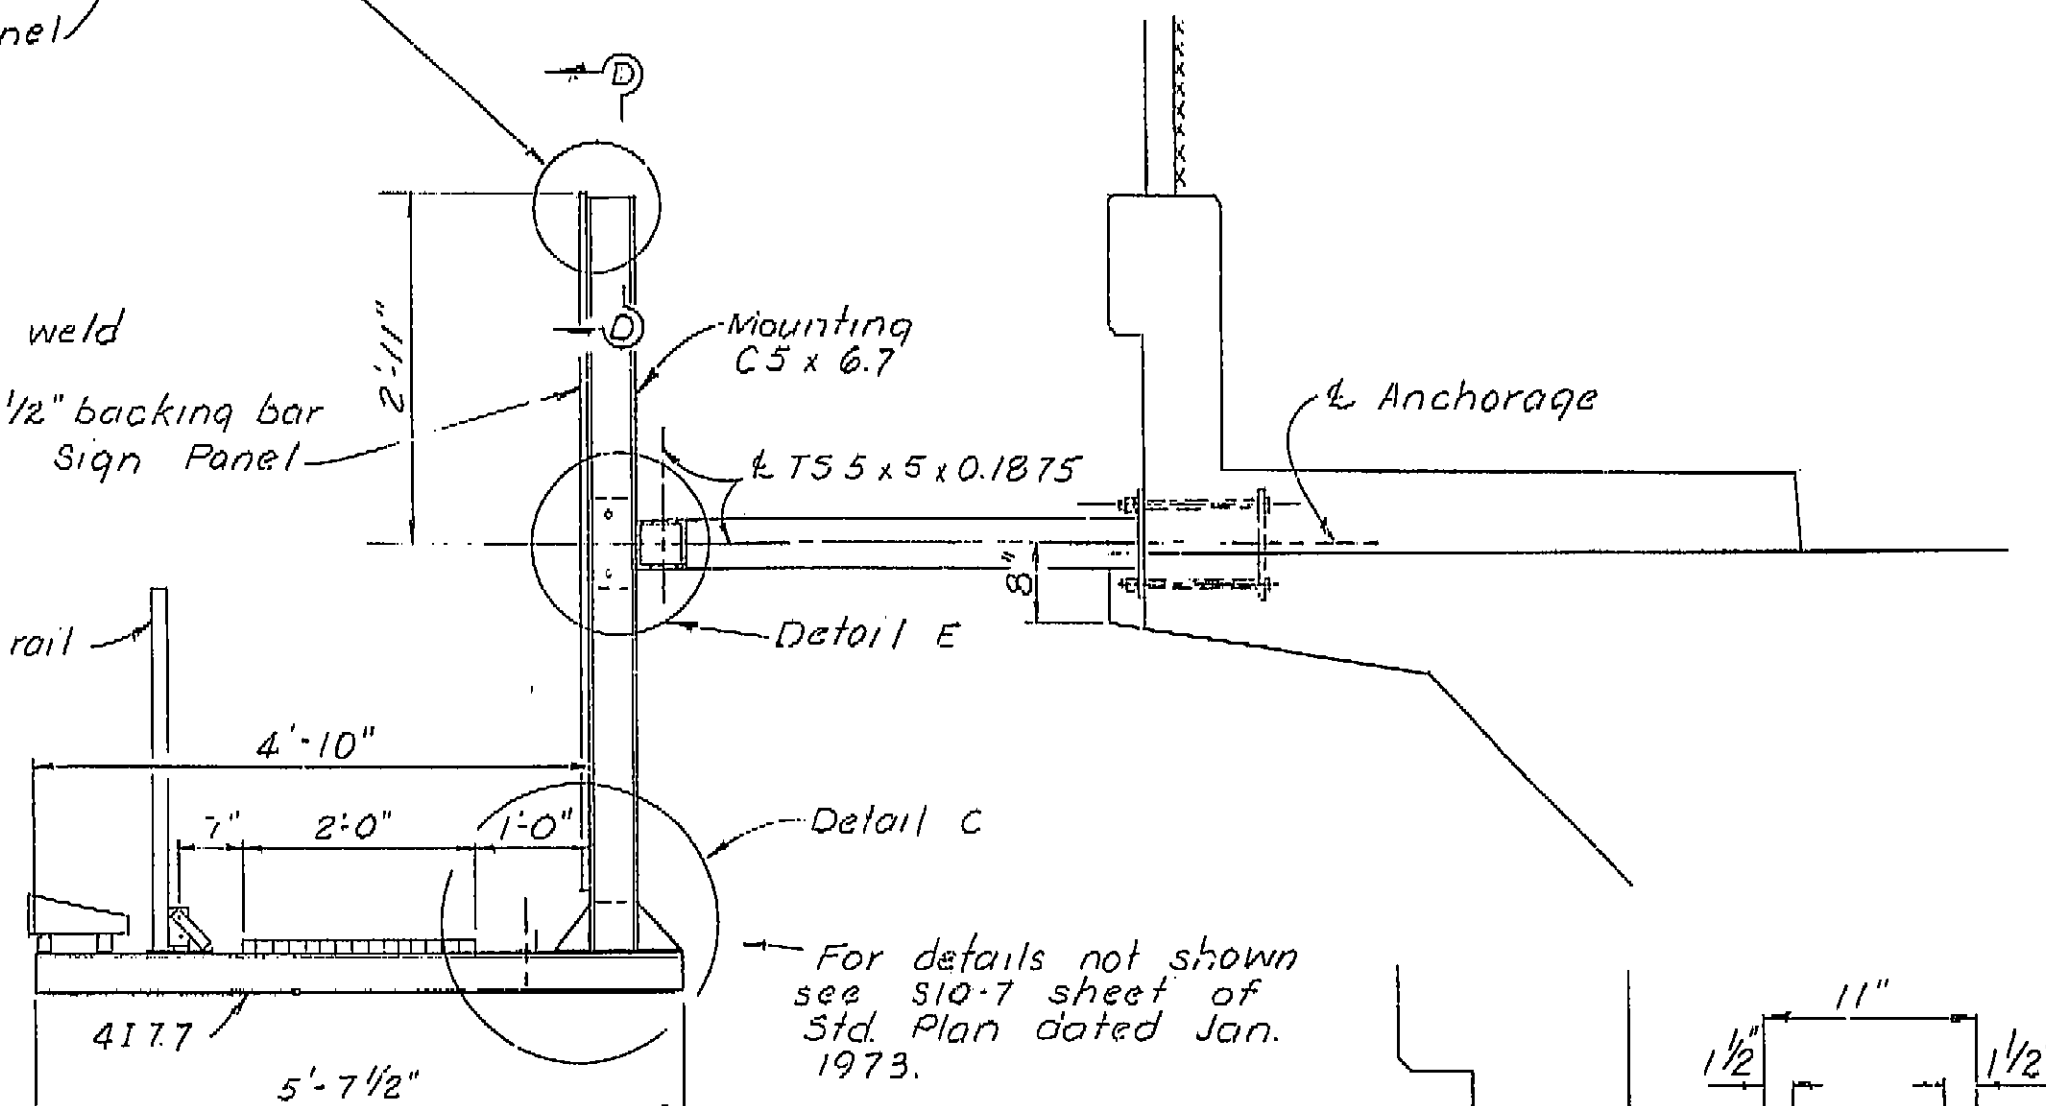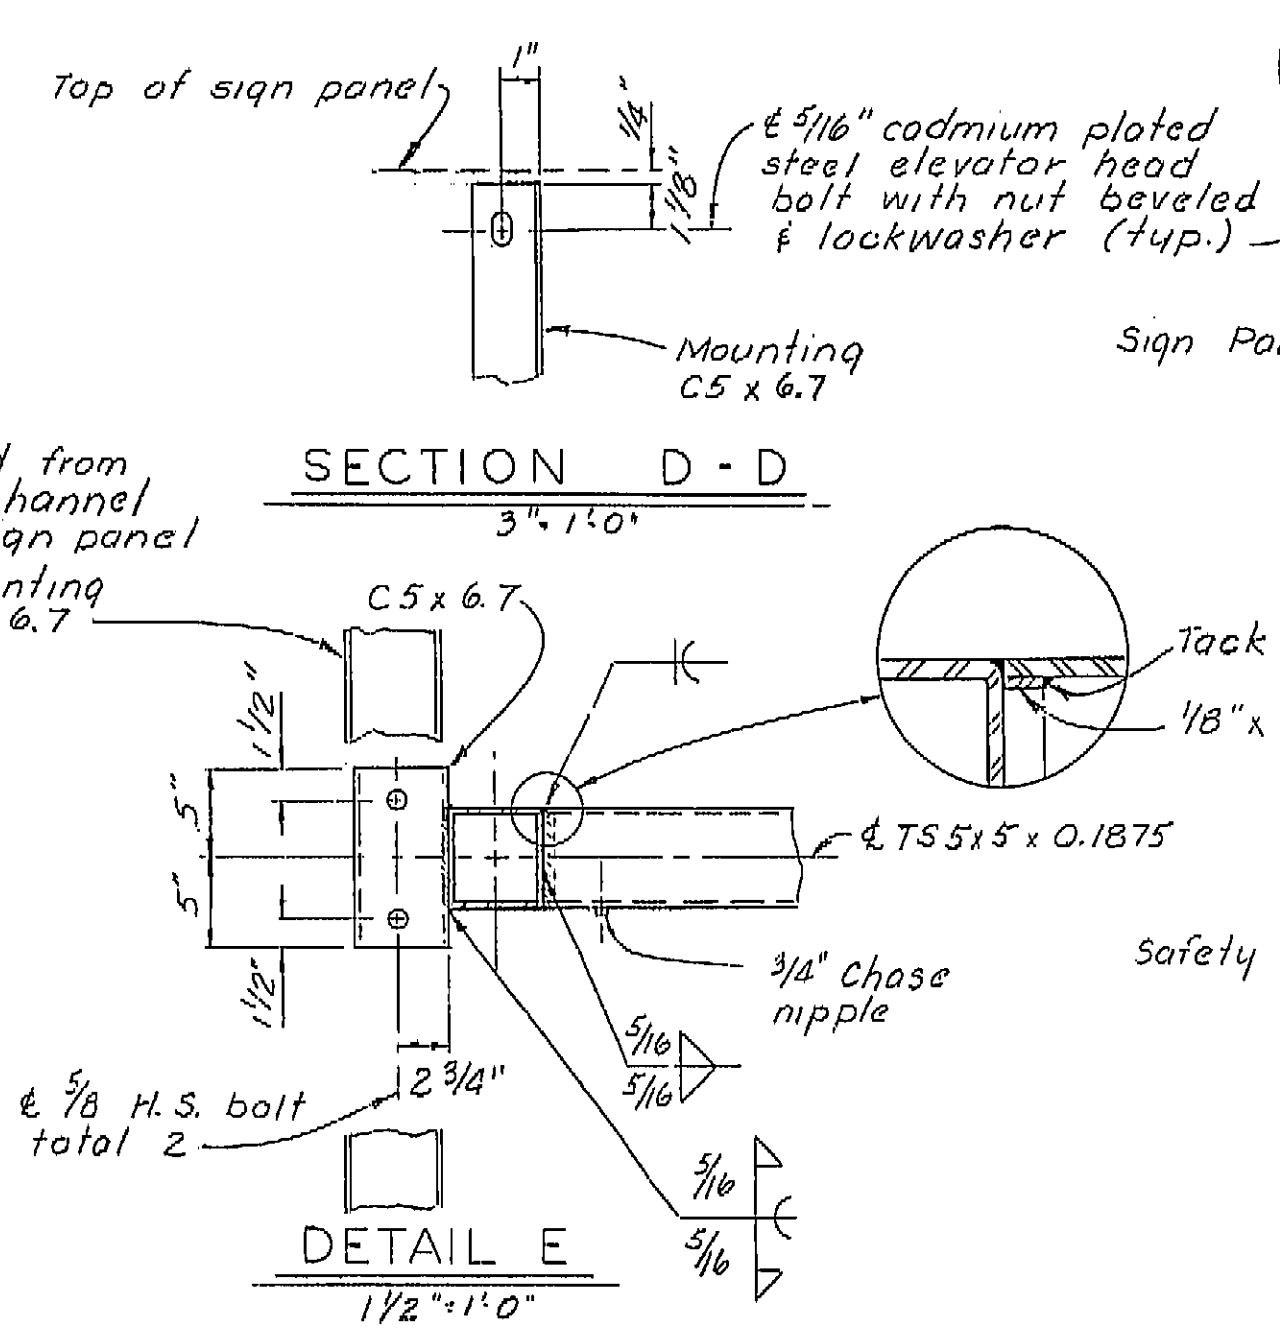


**AS BUILT PLANS**  
 Contract No. 01-061224  
 Date Completed 1/24/77  
 Document No. 1000-2617

9/3/76	Additional reinf at anchorage	TBM	LRV
MARK	DATE	DESCRIPTION	BY
		REVISIONS	CHD

NO AS BUILT CORRECTIONS  
**AS BUILT**  
 CORRECTIONS BY J.A. Schroeder  
 CONTRACT NO. 01-061224  
 DATE 8-03-76 R.T. 4-1-77

CONTRACT CHANGE ORDER NO. 27  
 SHEET 2 OF 2


DESIGN	By <u>RA Rogers 6-74</u>	Checked <u>T.J. Harrington 7/74</u>	State of <b>CALIFORNIA</b> DEPARTMENT OF TRANSPORTATION	BRIDGE DEPARTMENT DESIGN SECTION	12	BRIDGE NO. 4-236	PAINTER STREET OVERCROSSING			
DETAILS	By <u>Ben Moten 6/74</u>	Checked <u>T.J. Harrington 7/74</u>		PROJECT ENGINEER <u>C.P. Johnson</u>		POST MILE	MOUNTING DETAILS			
QUANTITIES	By <u>J.W.M. 8/74</u>	Checked <u>Ben Moten 9/74</u>				53.2				
ORIGINAL SCALE IN INCHES ENR. REDUCED, PL. A115.				CU 01502 WO 166223	Disregard prints bearing earlier revision dates →	REVISION DATES (PRELIMINARY STAGE ONLY)		SHEET	OF	
								2	2	

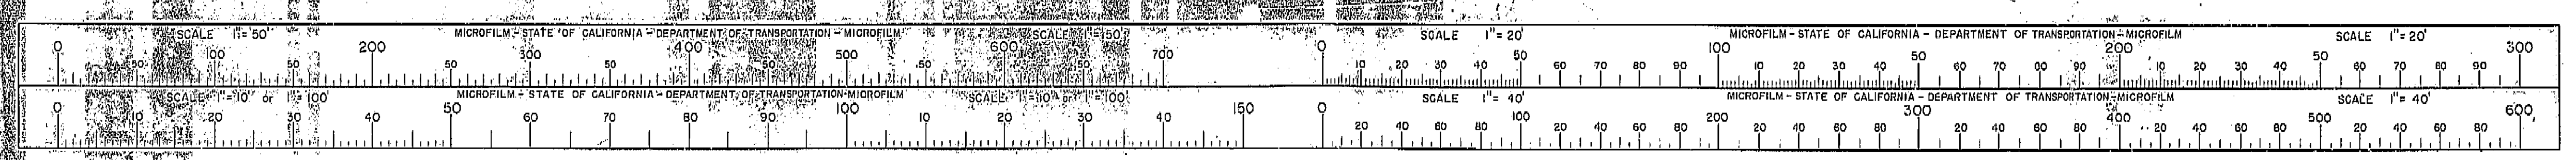


I HEREBY CERTIFY THAT THIS IS A TRUE AND ACCURATE COPY OF THE ABOVE DOCUMENT TAKEN UNDER MY DIRECTION AND CONTROL ON THIS DATE IN SACRAMENTO, CALIFORNIA PURSUANT TO AUTHORIZATION BY THE DIRECTOR OF TRANSPORTATION.  
 DATE 1/14/77 SIGNATURE Joseph M. Costa TITLE Supervisor



DIST.	COUNTY	ROUTE	POST MILES-TOTAL PROJECT	SHEET NO.	TOTAL SHEETS
1	HUM	101	251.5 / R53.9	131	150

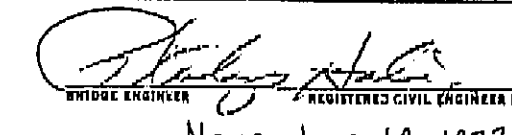  
 REGISTERED CIVIL ENGINEER NO. 1267  
 DATE APPROVED November 19, 1973

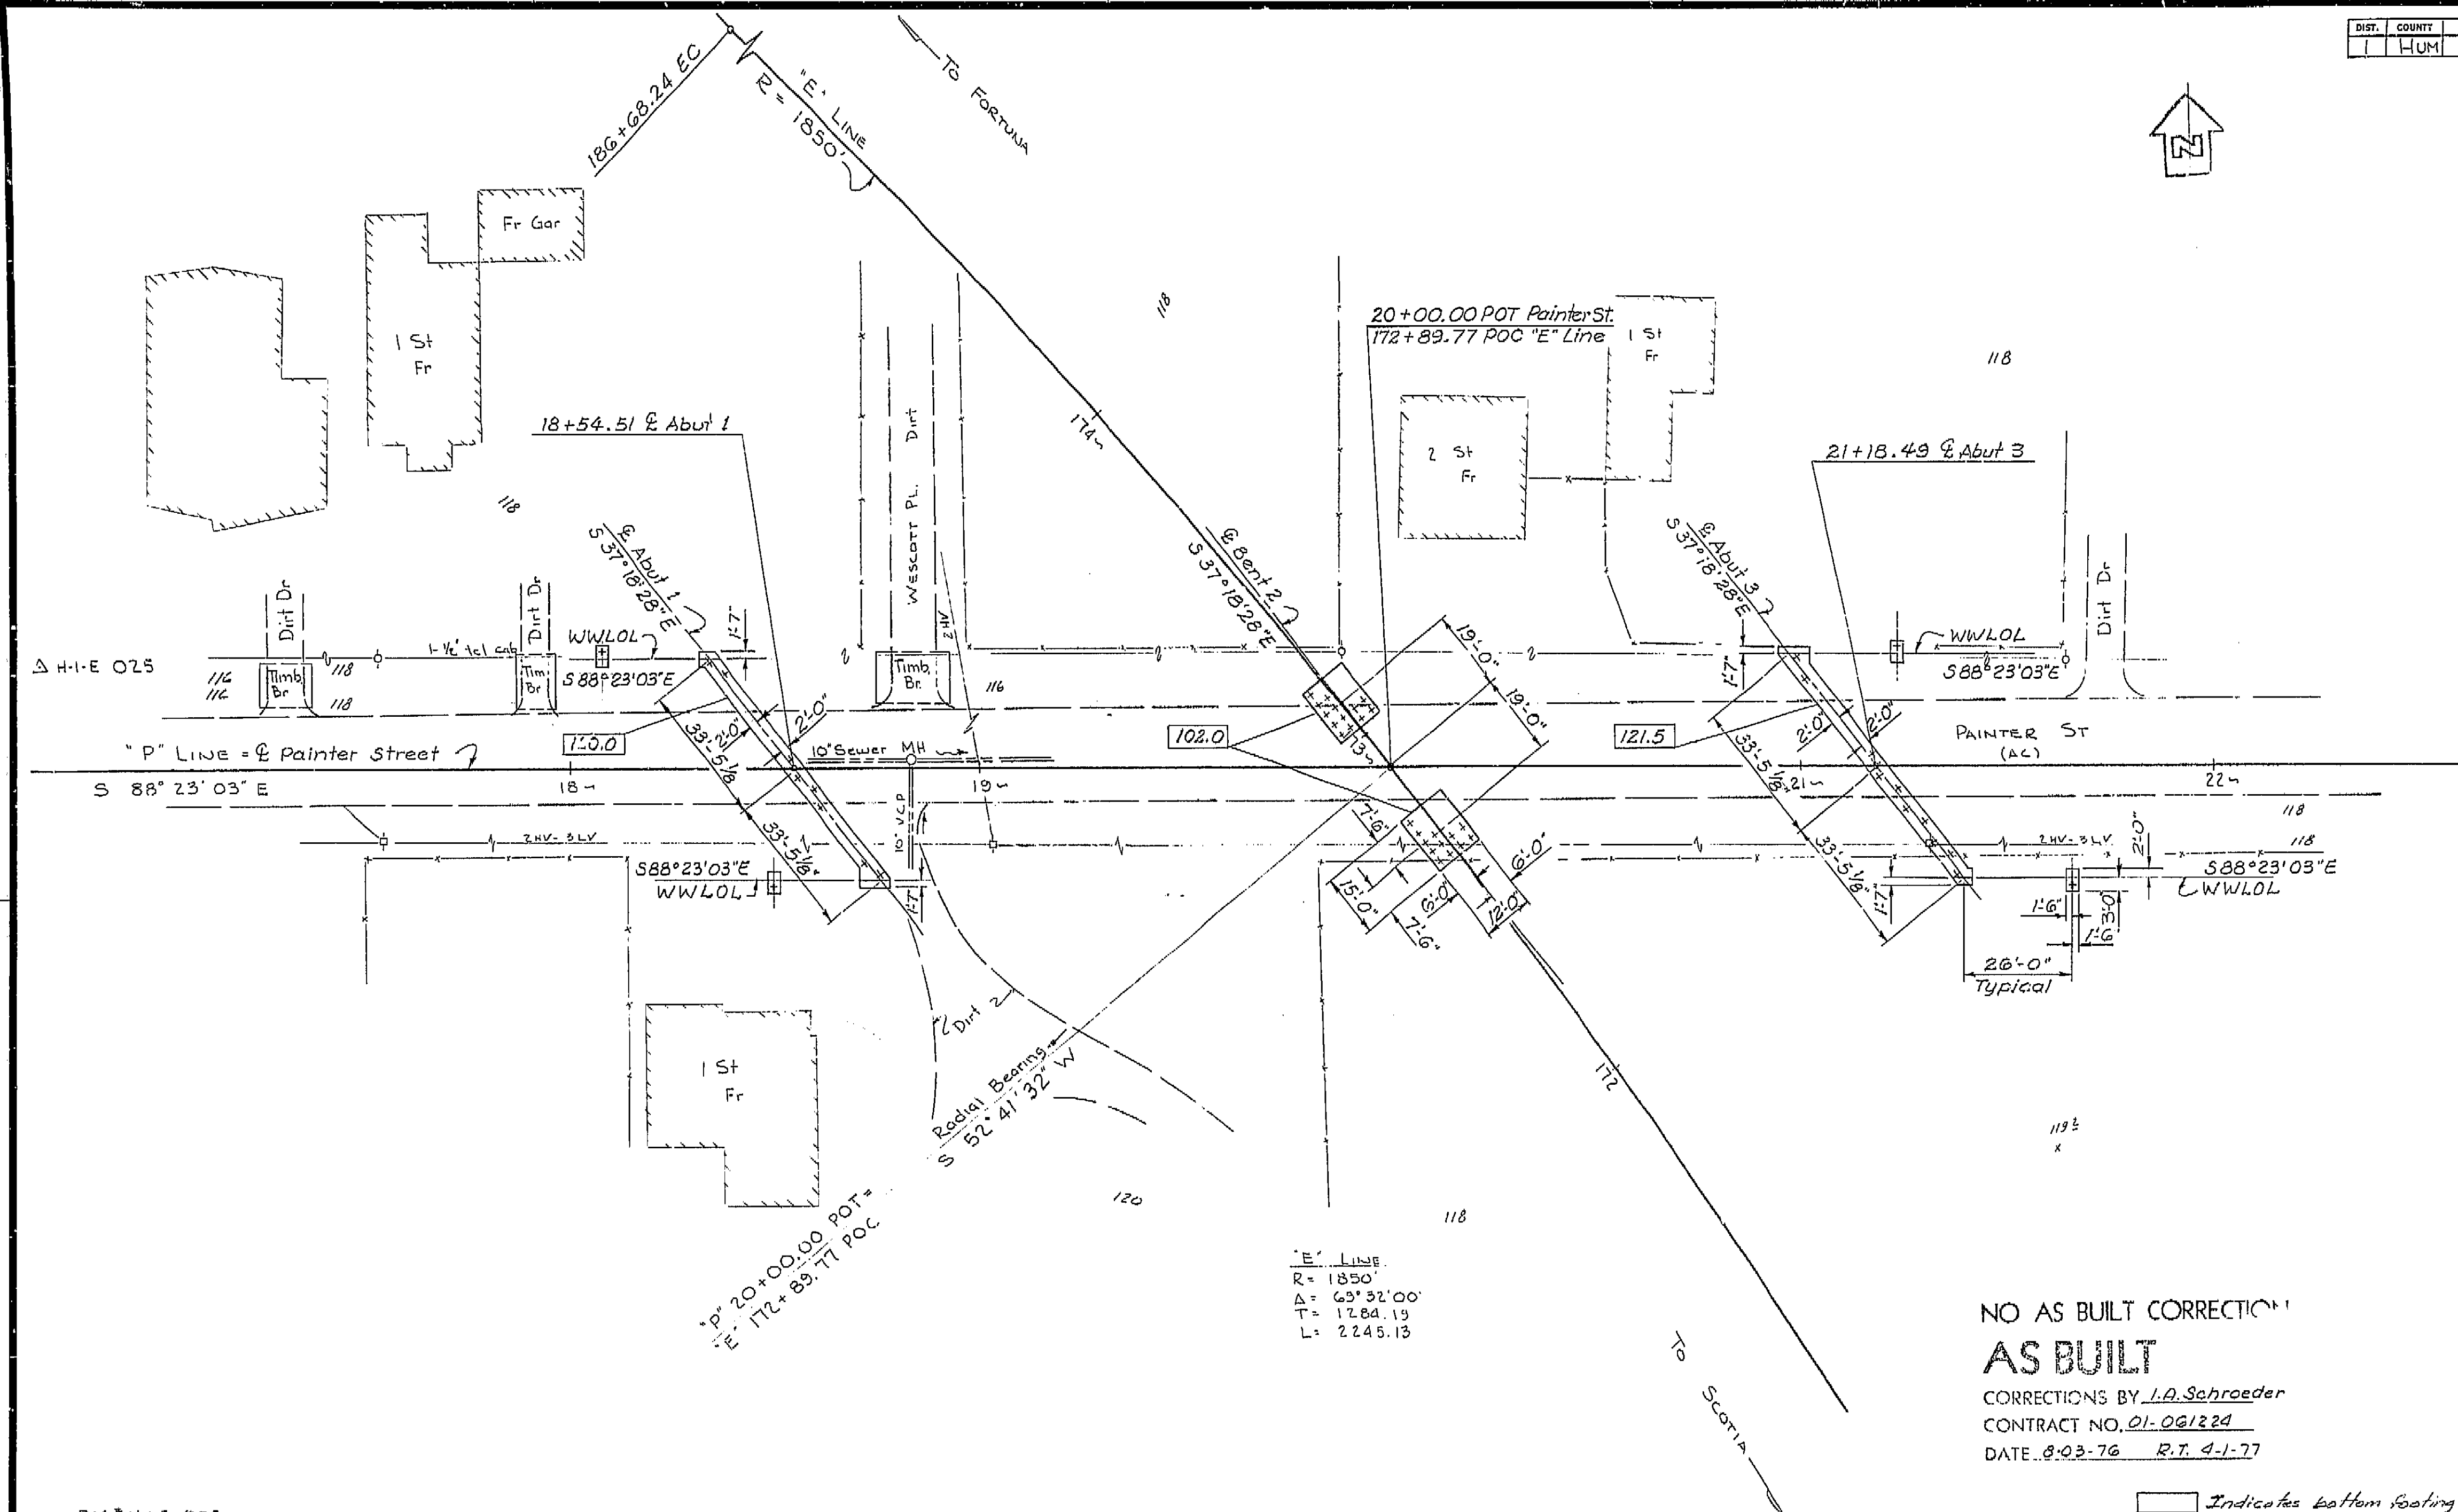

BM "H-I-E 025"  
 Fd. Std. CHC disc 225'  
 L "E" 175+45  
 El 116.80  
 NOTE: 2-Ft. Contours

**AS BUILT PLANS**  
 Contract No. 01-061224  
 Date Completed 11-68  
 Document No. 1000-2617

SCALE: 1" = 20'  
 LEVEL DATUM: MSL  
 FOR ALIGNMENT TIES SEE PR. 4236-4  
 CONTOURS AS OF OCTOBER 1968  
 SITE PLAN FROM DISTRICT DATA  
 SURVEY BY: EGB DATE 10-68  
 DRAWN BY: RRB DATE 11-68  
 TRACED BY: RRB DATE 11-68

NO AS BUILT CORRECTIONS  
**AS BUILT**  
 CORRECTIONS BY L.A. Schroeder  
 CONTRACT NO. 01-061224  
 DATE 8-23-76 R.T. 4-1-77

Indicates bottom seating elevation

PR. 4236-1

BRIDGE DEPARTMENT <b>DESIGN SECTION</b> Project Engineer: <u>P.W. Olson</u> DESIGN: By <u>W. H. H. 3/70</u> Checked: <u>P. J. Olson</u> DETAILS: By <u>R. Green 4/70</u> Checked: <u>P. J. Olson</u> QUANTITIES: By <u>P. J. Olson 7/73</u> Checked: <u>R. Green</u>		STATE OF CALIFORNIA DEPARTMENT OF TRANSPORTATION PAINTER STREET OVERCROSSING FOUNDATION PLAN BRIDGE NO. <u>4-236</u> POST MILE <u>53.2</u> DRAWING NO. <u>6-4</u> SHEET <u>8</u> OF <u>10</u>	
--	--	--	--

WO 061221  
 CU 01201


I HEREBY CERTIFY THAT THIS IS A TRUE AND ACCURATE COPY OF THE ABOVE DOCUMENT TAKEN UNDER MY DIRECTION AND CONTROL ON THIS DATE IN SACRAMENTO, CALIFORNIA PURSUANT TO AUTHORIZATION BY THE DIRECTOR OF TRANSPORTATION.  
 DATE 4/14/77 SIGNATURE Joseph M. Gato TITLE Supervisor






DIST.	COUNTY	ROUTE	POST MILES—TOTAL PROJECT	POST MILE	SHEET NO.	TOTAL SHEETS
01	Hum	101	R51.5 / R53.9	132	150	

DESIGN SECTION SUPERVISOR  
 DATE APPROVED: November 19, 1973

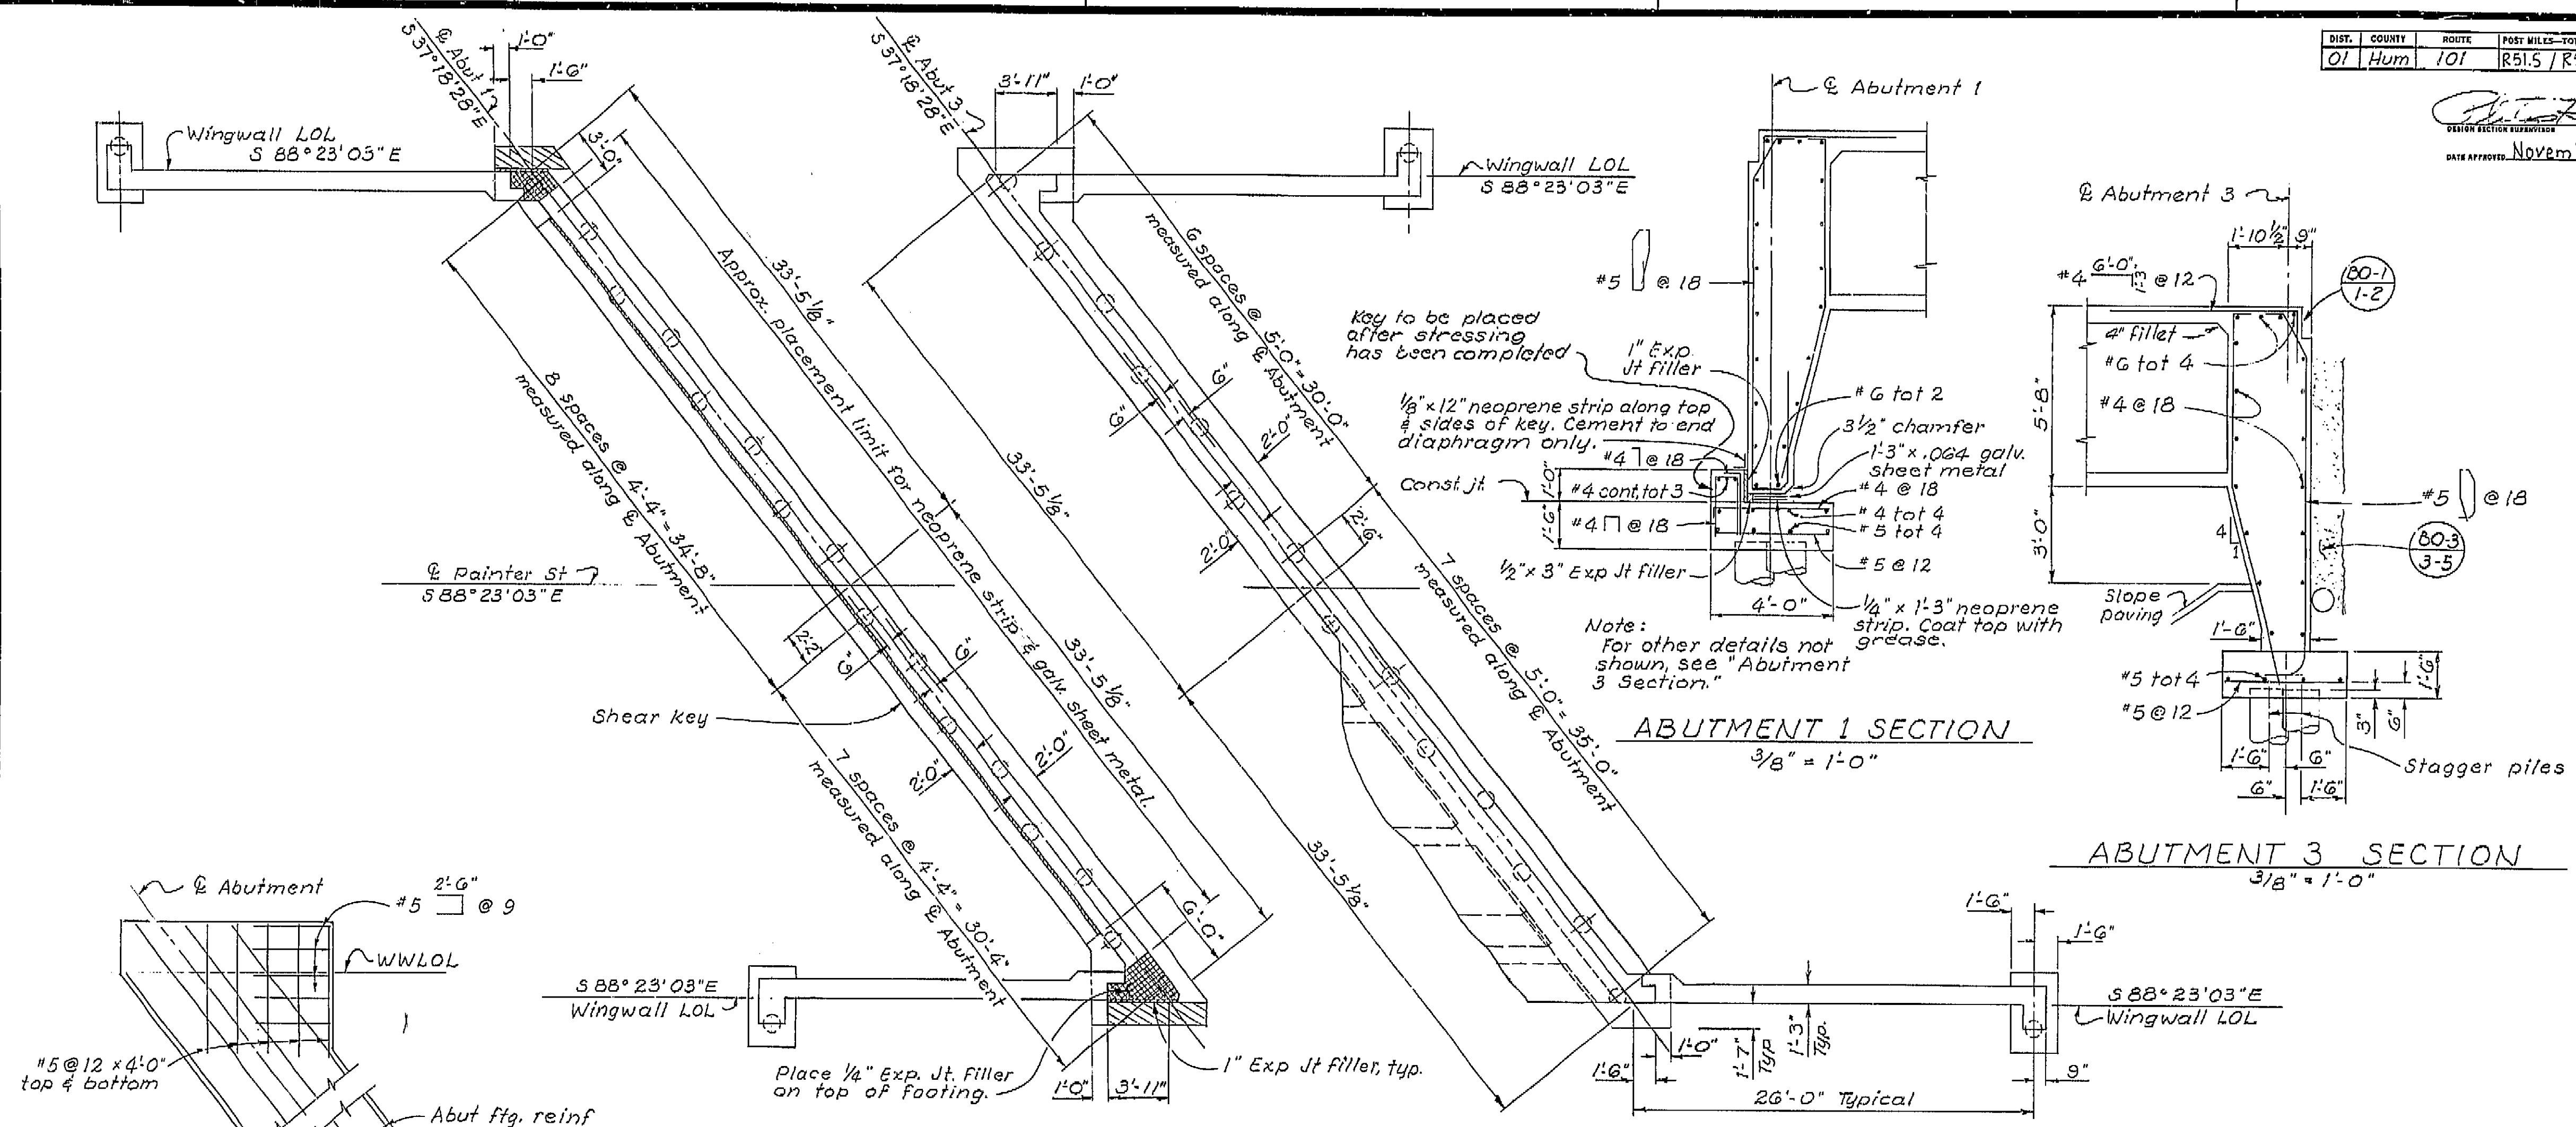


ABUTMENT 1 SECTION  
 $\frac{3}{8}'' = 1'-0''$


ABUTMENT 3 SECTION  
 $\frac{3}{8}'' = 1'-0''$

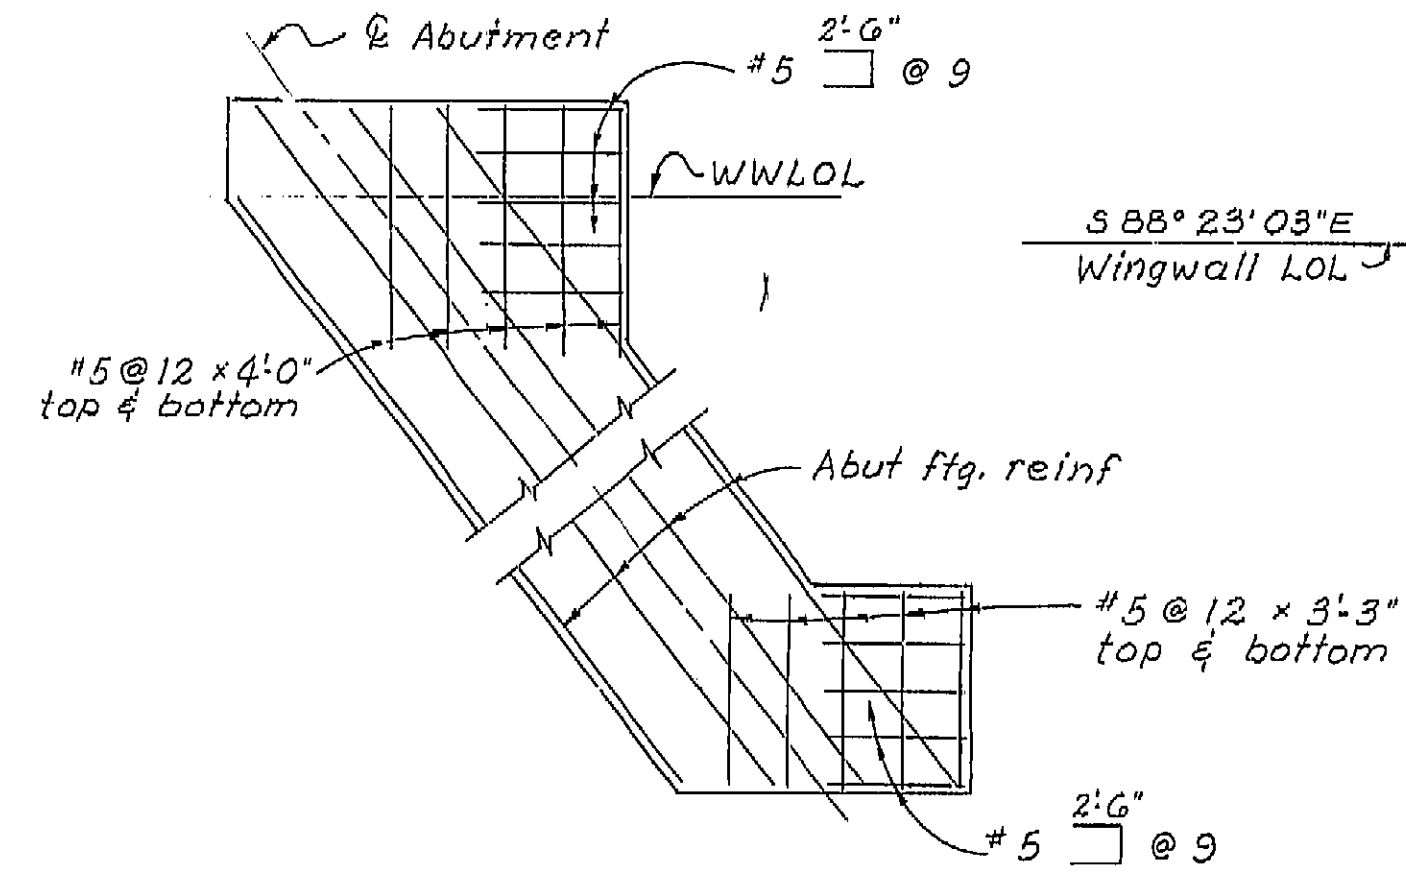

FOOTING CORNER DETAIL  
 $\frac{3}{8}'' = 1'-0''$

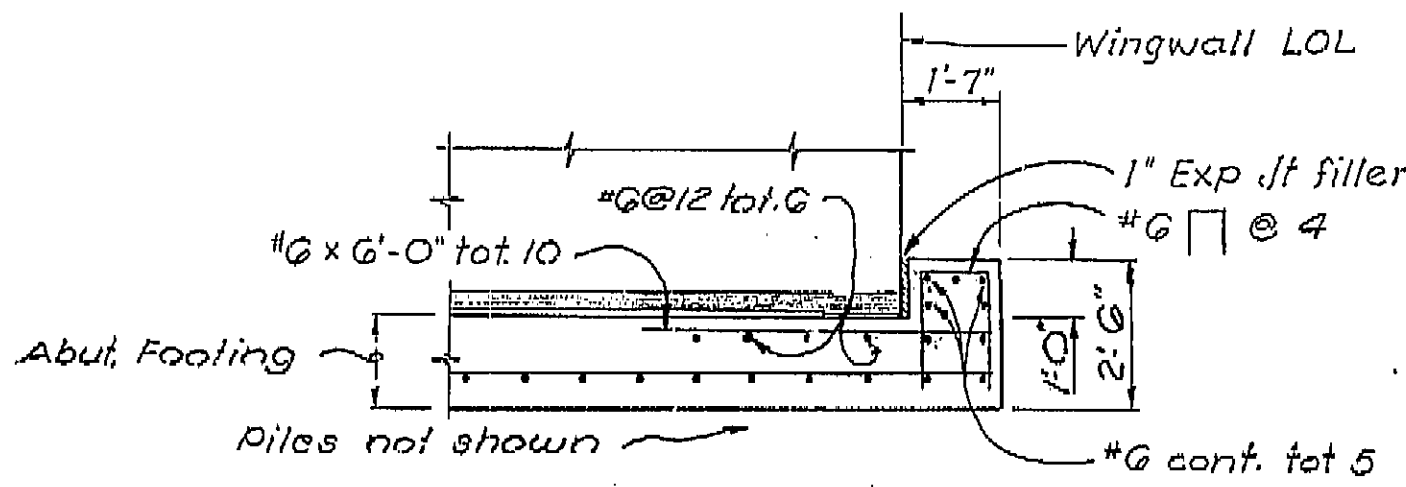


SECTION  
 SHEAR KEY DETAIL  
 $\frac{3}{8}'' = 1'-0''$

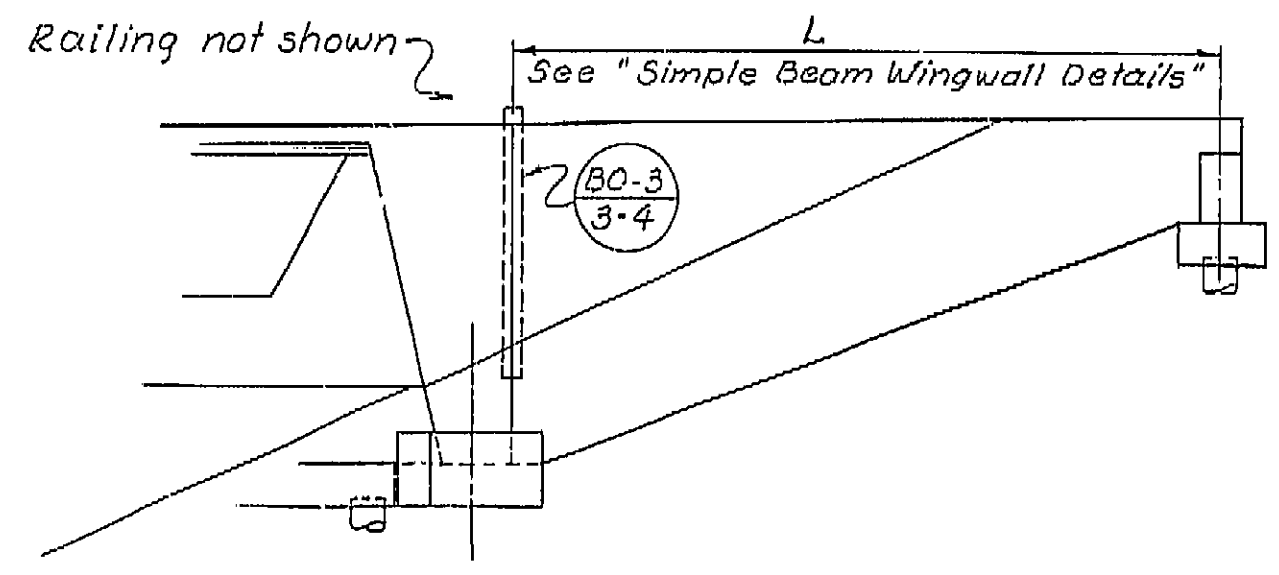

WINGWALL ELEVATION  
 $\frac{3}{16}'' = 1'-0''$

Note:  
 For Abutment corners and Wingwall details,  
 see "Simple Beam Wingwall Details" sheet.

NO AS BUILT CORRECTION  
**AS BUILT**  
 CORRECTIONS BY: L.A. Schroeder  
 CONTRACT NO. 01-06123d  
 DATE 6-03-76 R.T. 4-1-77

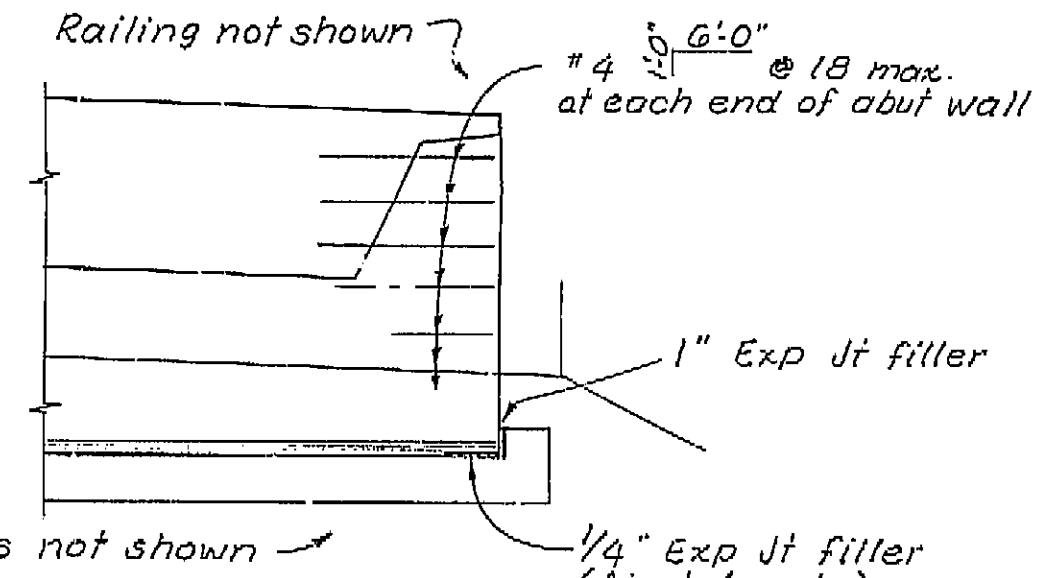


PART ABUT. ELEVATION  
 $\frac{3}{16}'' = 1'-0''$

**AS BUILT PLANS**  
 Contract No. 01-06123d  
 Date Completed 10-26-77  
 Document No. 1000-2617

BRIDGE DEPARTMENT DESIGN SECTION <b>6</b>		STATE OF CALIFORNIA DEPARTMENT OF TRANSPORTATION	
Project Engineer: P. W. Olson		PAINTER STREET OVERCROSSING	
DESIGN	By: Helmer Steg	ABUTMENT DETAILS	
CHECKED	P. W. Olson	BRIDGE NO.	4-236
DETAILS	By: R. Green 3/70	POST MILE	53.2
CHECKED	P. W. Olson	DRAWING NO.	4
QUANTITIES	By: D. Williams 4/73	SHEET	4
CHECKED	R. Green	OF	10

I HEREBY CERTIFY THAT THIS IS A TRUE AND ACCURATE COPY OF THE ABOVE DOCUMENT TAKEN UNDER MY DIRECTION AND CONTROL ON THIS DATE IN SACRAMENTO, CALIFORNIA PURSUANT TO AUTHORIZATION BY THE DIRECTOR OF TRANSPORTATION.  
 DATE 4/14/77 BY Joseph M. Guter TITLE Supervisor

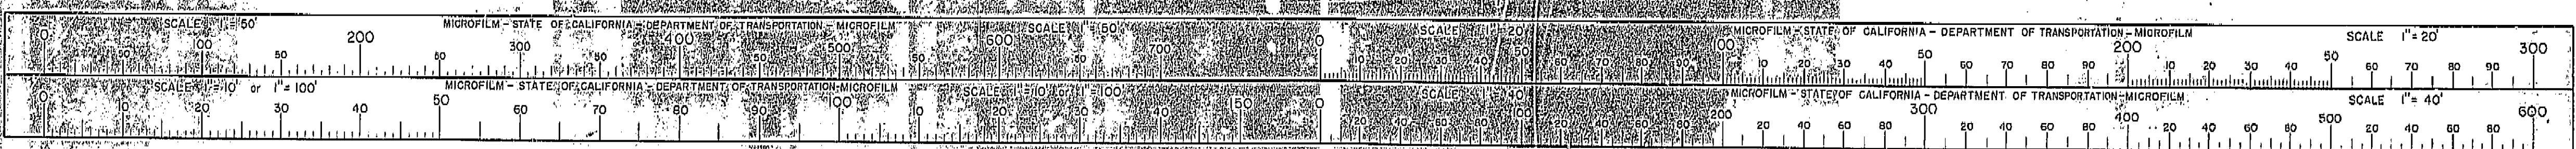











DIST.	COUNTY	ROUTE	POST MILES-TOTAL PROJECT	SHEET NO.	TOTAL SHEETS
01	Hum	101	R61.5/R63.9	133	150

DESIGNED BY *Philip H. ...*  
 DATE APPROVED: November 19, 1913

Note  
 All reinforcement #18 unless noted otherwise.  
 Numbers at ends of bars indicate distance in feet from Reference line for top reinforcement and from E Structure for bottom reinforcement.

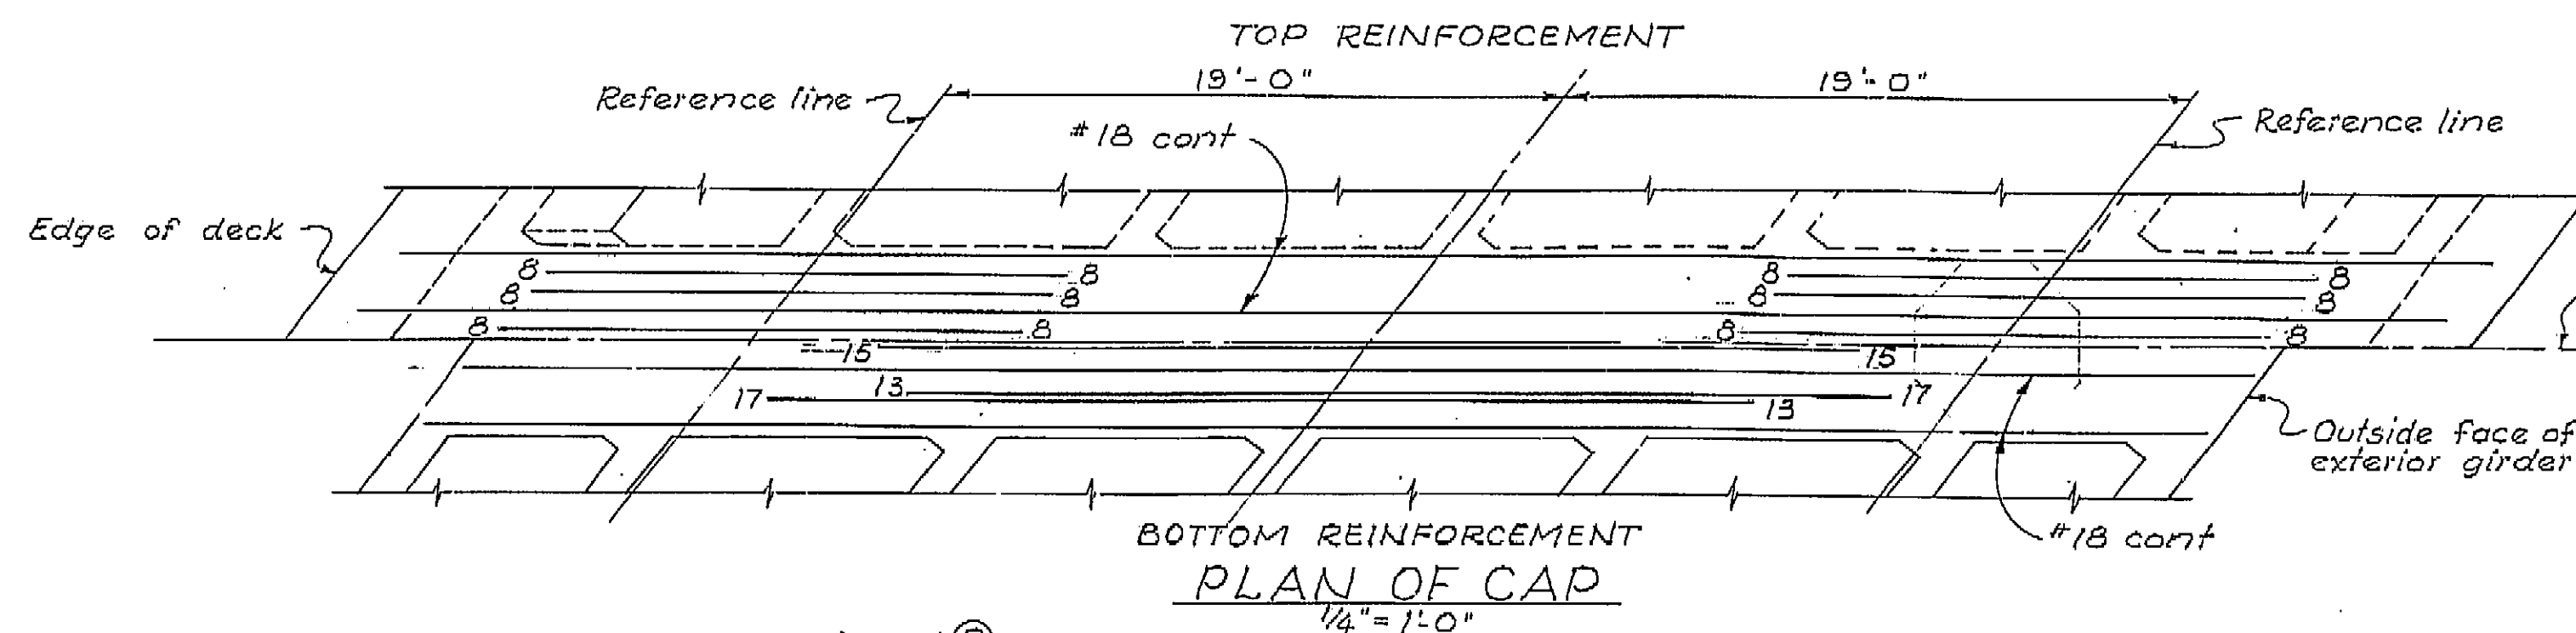

Reinforcement symmetrical about E Bent 2  
 S 37° 18' 28" E

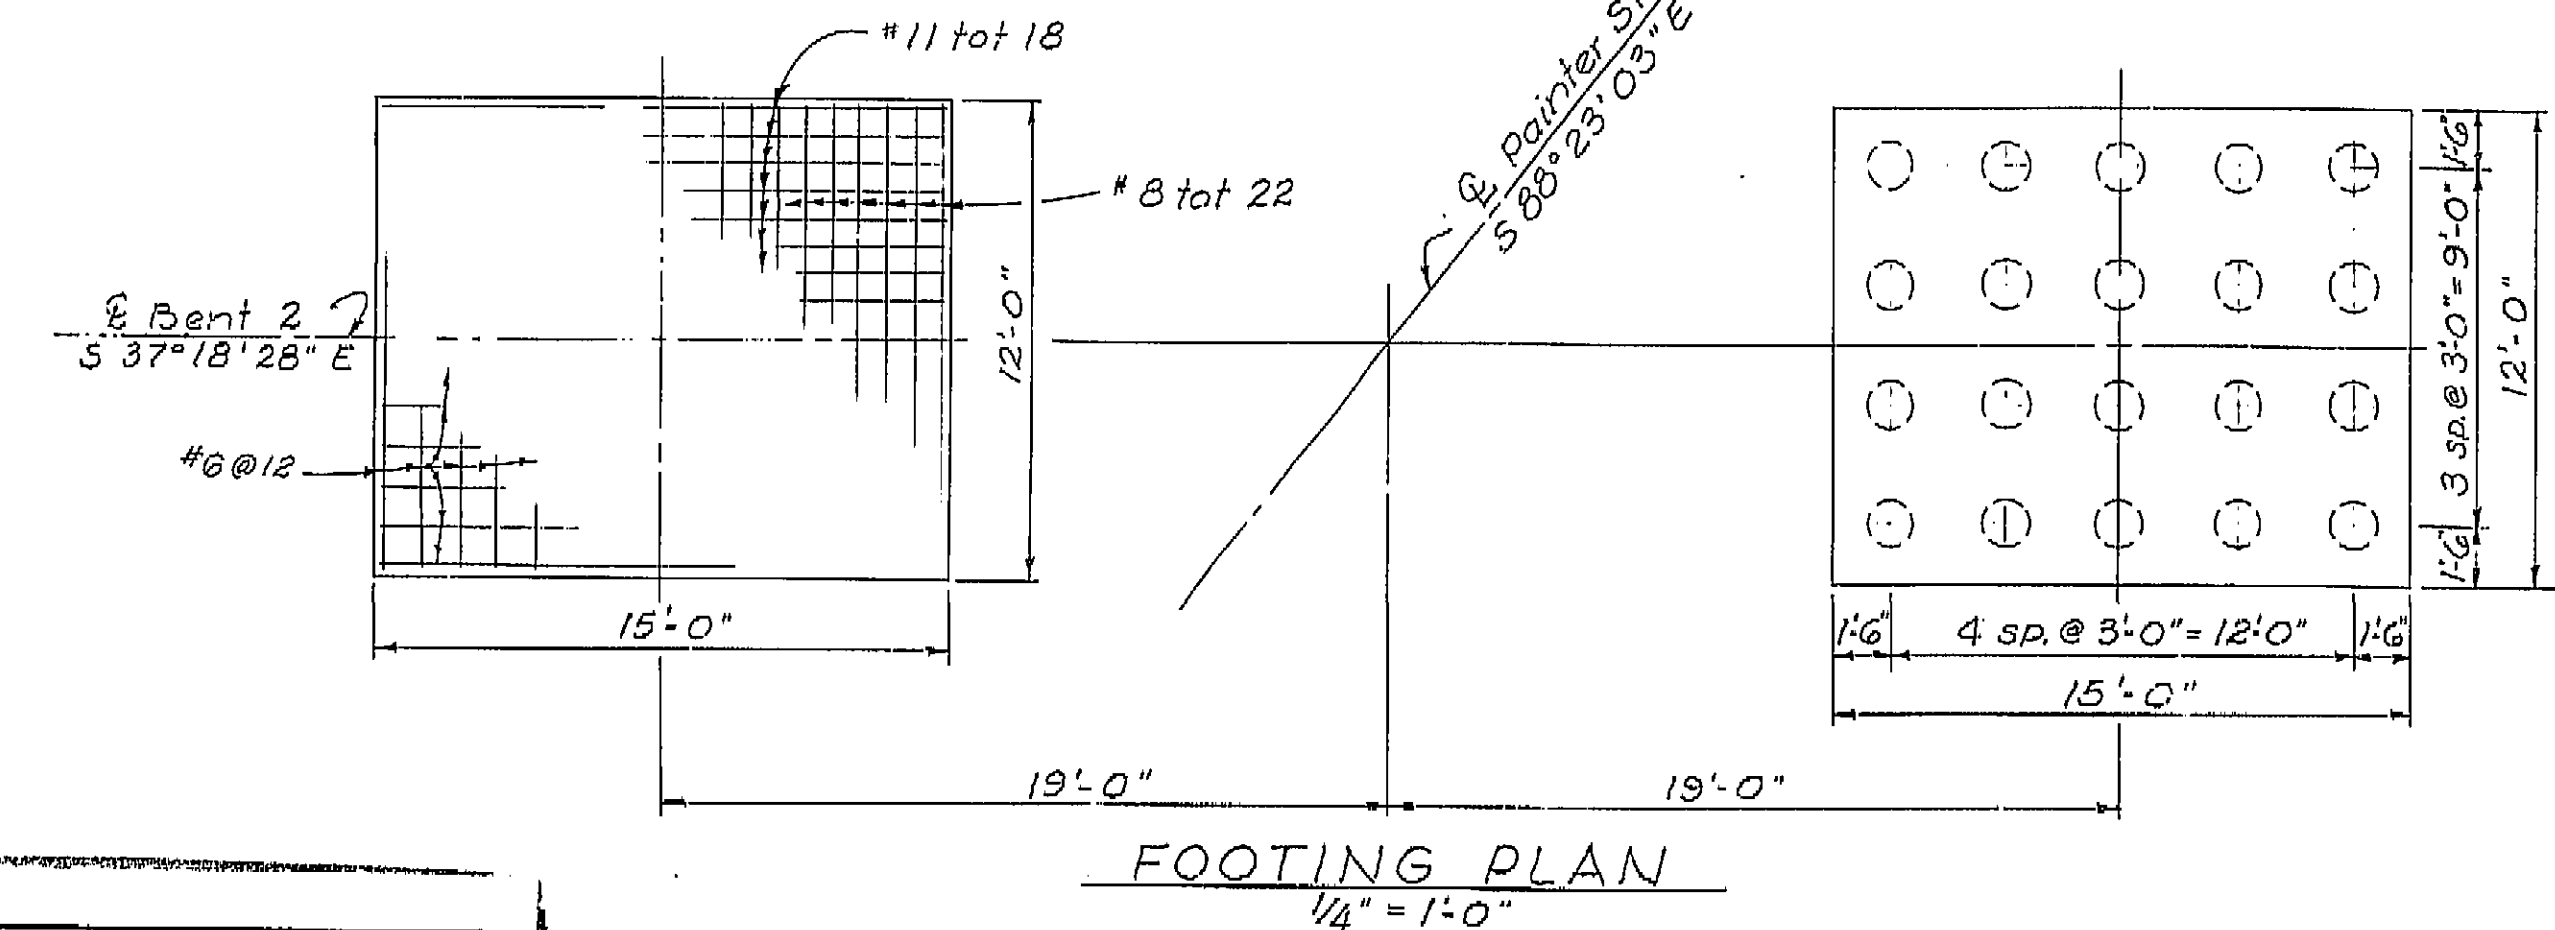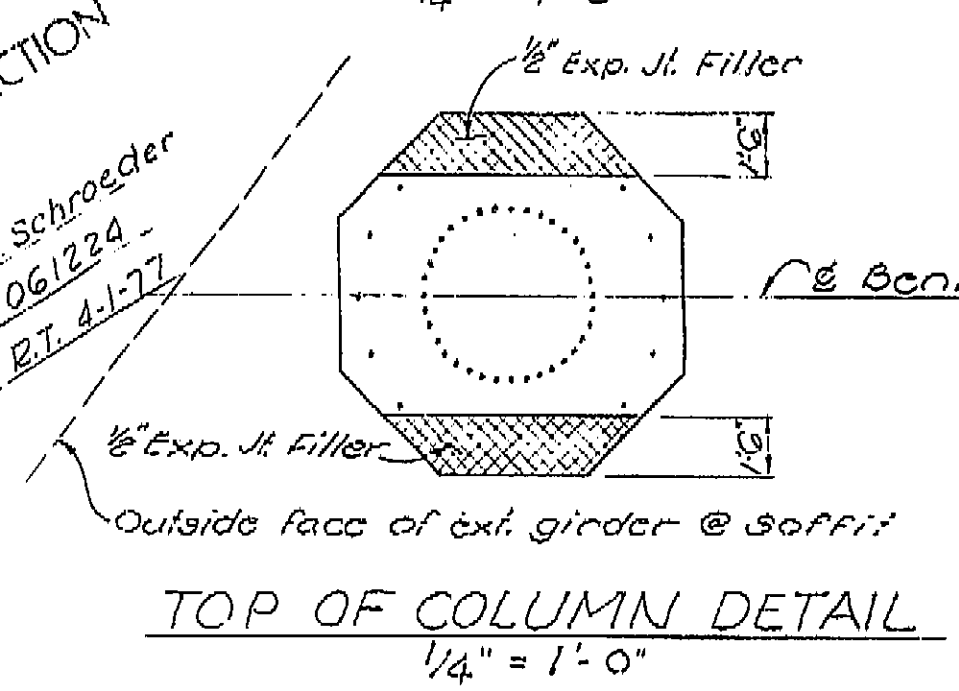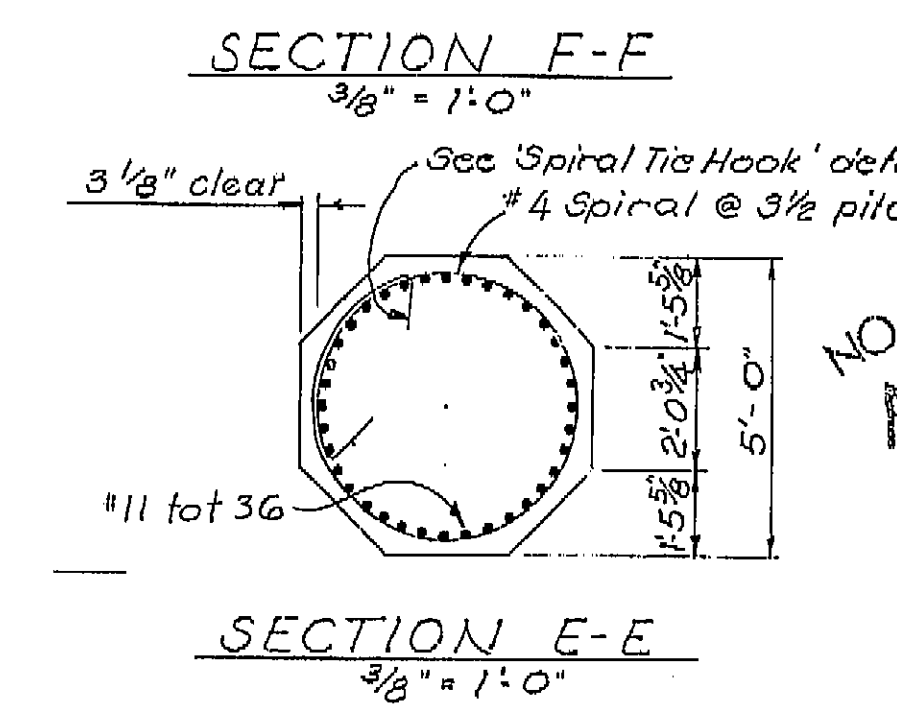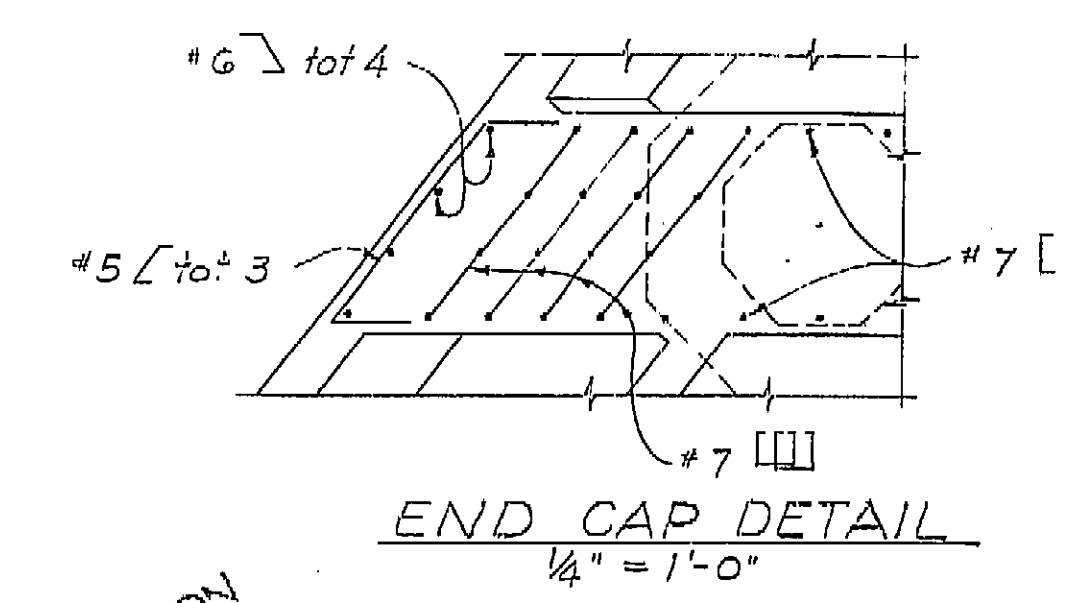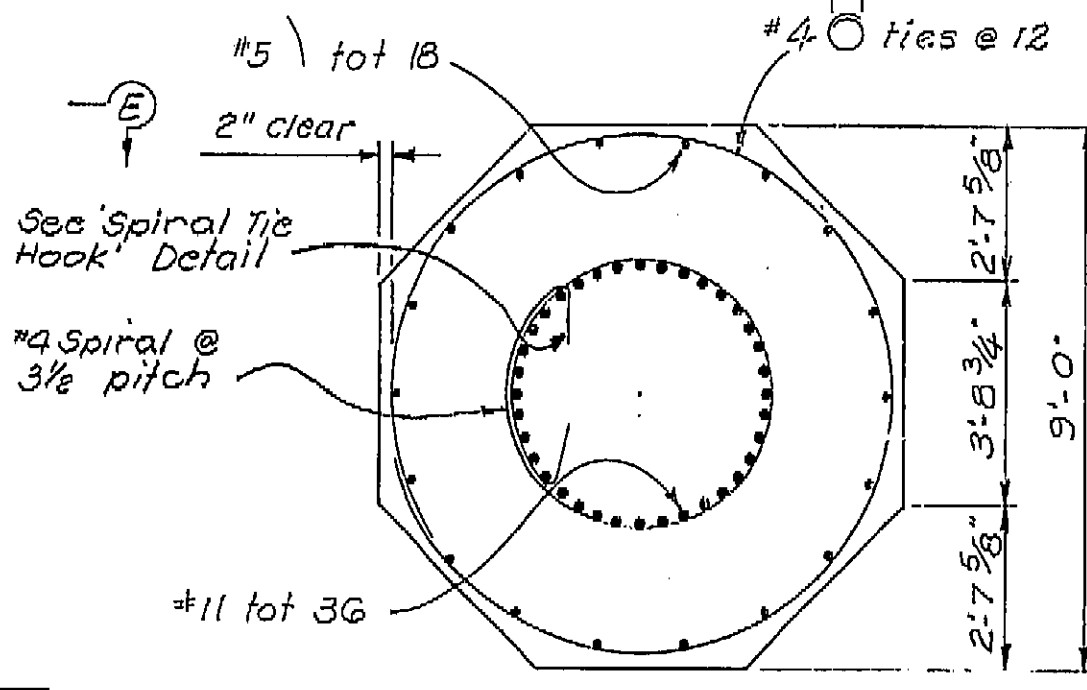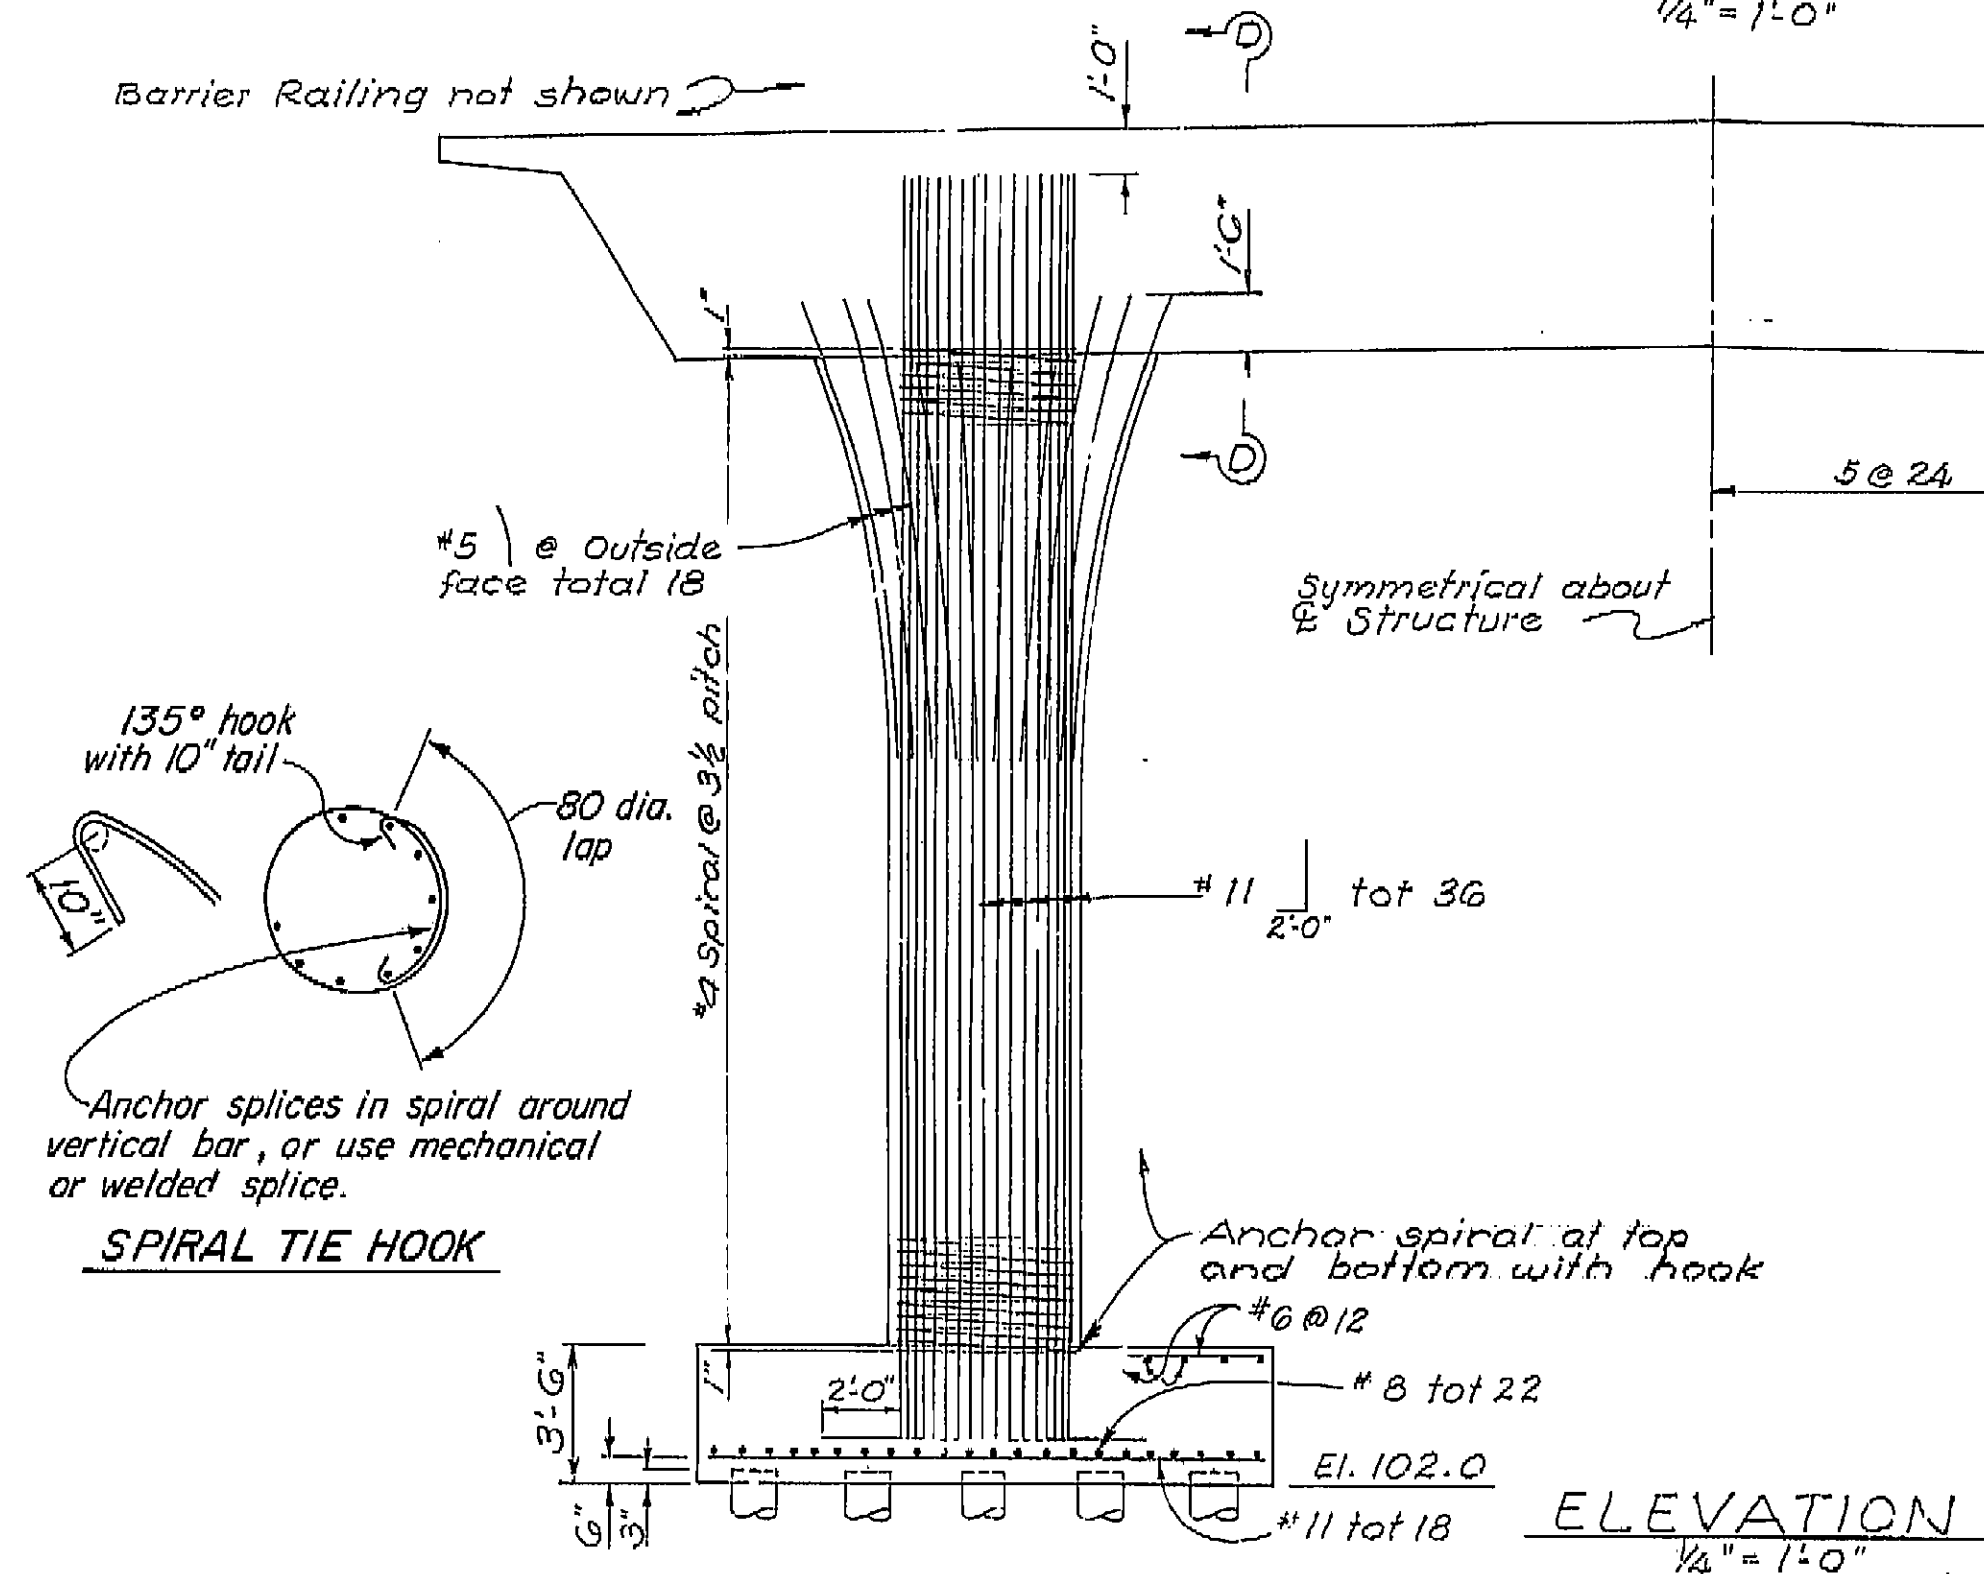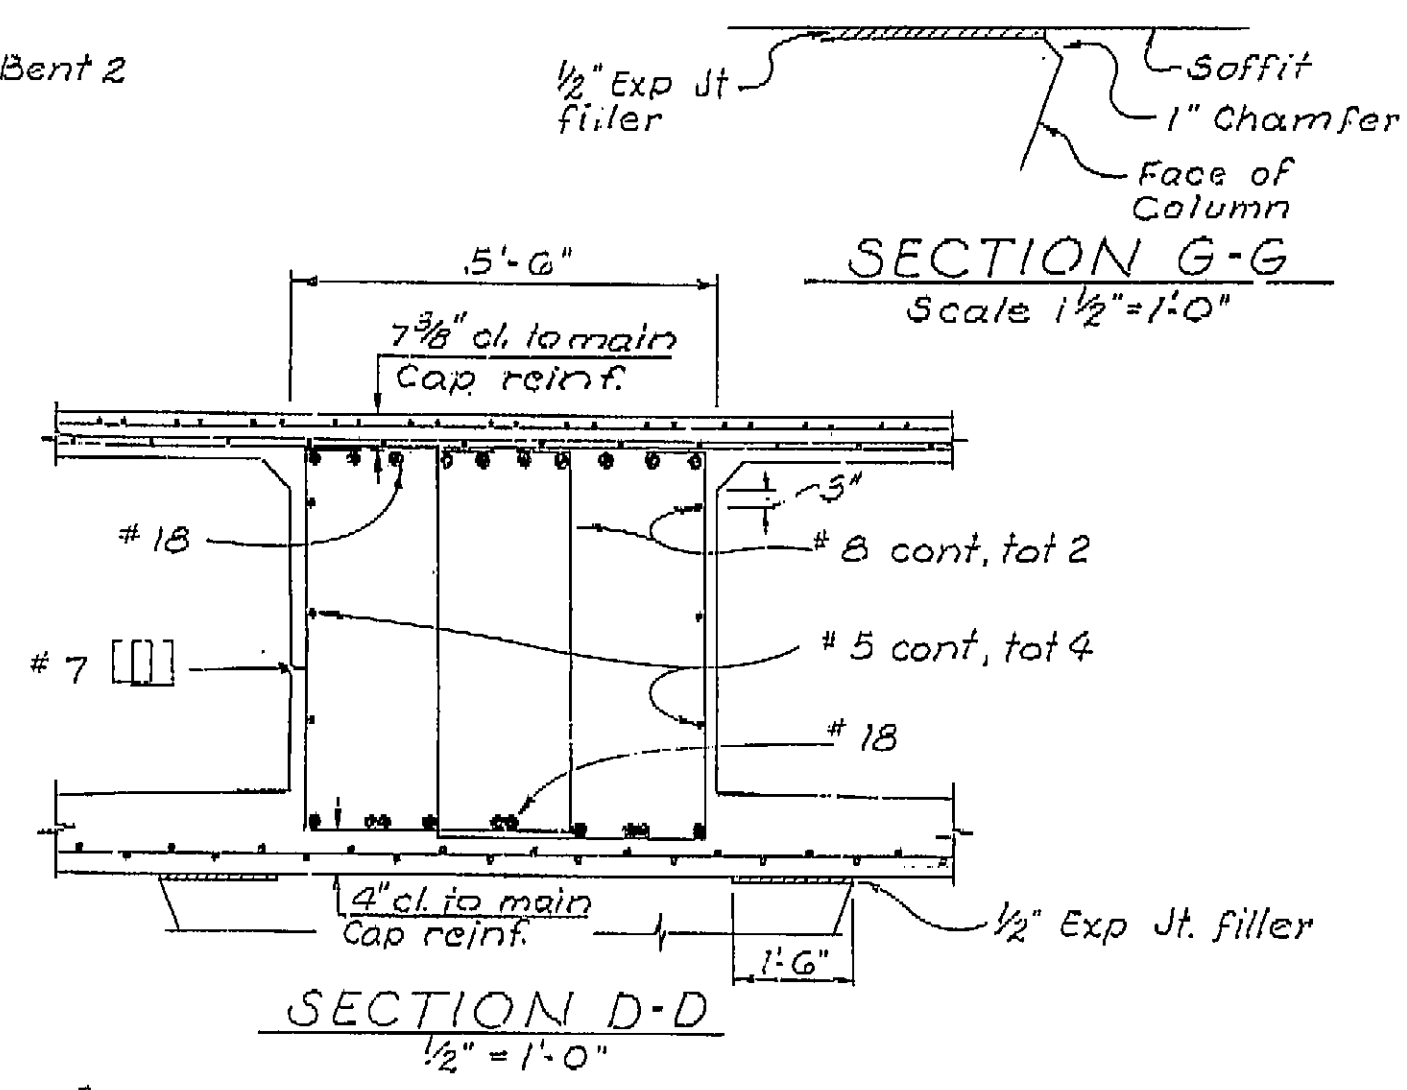

NO AS BUILT CORRECTION  
 AS BUILT  
 CORRECTIONS BY I.A. Schroeder  
 CONTRACT NO. 01-061224  
 DATE 8-03-76 ET 4-1-77

BRIDGE DEPARTMENT DESIGN SECTION 6		STATE OF CALIFORNIA DEPARTMENT OF TRANSPORTATION	
Project Engineer: <i>P. H. ...</i>		PAINTER STREET OVERCROSSING	
DESIGN	By <i>Melina 3/76</i>	BENT 2 DETAILS	
CHECKED	By <i>P. H. ...</i>	BRIDGE NO.	4-236
DETAILS	By <i>R. Green 4/70</i>	POST MILE	53.2
CHECKED	By <i>P. H. ...</i>	DRAWING NO.	
QUANTITIES	By <i>R. Green 3/73</i>	SHEET	5 OF 10
CHECKED	By <i>R. Green</i>	(PRELIMINARY STAGE ONLY)	


AS BUILT PLANS  
 Contract No. 01-061224  
 Date Completed  
 Document No. 1000-2617


I HEREBY CERTIFY THAT THIS IS A TRUE AND ACCURATE COPY OF THE ABOVE DOCUMENT TAKEN UNDER MY DIRECTION AND CONTROL ON THIS DATE IN SACRAMENTO, CALIFORNIA PURSUANT TO AUTHORIZATION BY THE DIRECTOR OF TRANSPORTATION.  
 DATE 4/14/77 SIGNATURE *Joseph M. ...* TITLE *Supervisor*






DIST.	COUNTY	ROUTE	POST MILES - TOTAL PROJECT	SHEET NO.	TOTAL SHEETS
01	Hum	101	RS1.5 / RS2.4	134	150

  
 DESIGNER SECTION SUPERVISOR  
 REGISTERED CIVIL ENGINEER NO. 12647  
 DATE APPROVED November 19, 1973

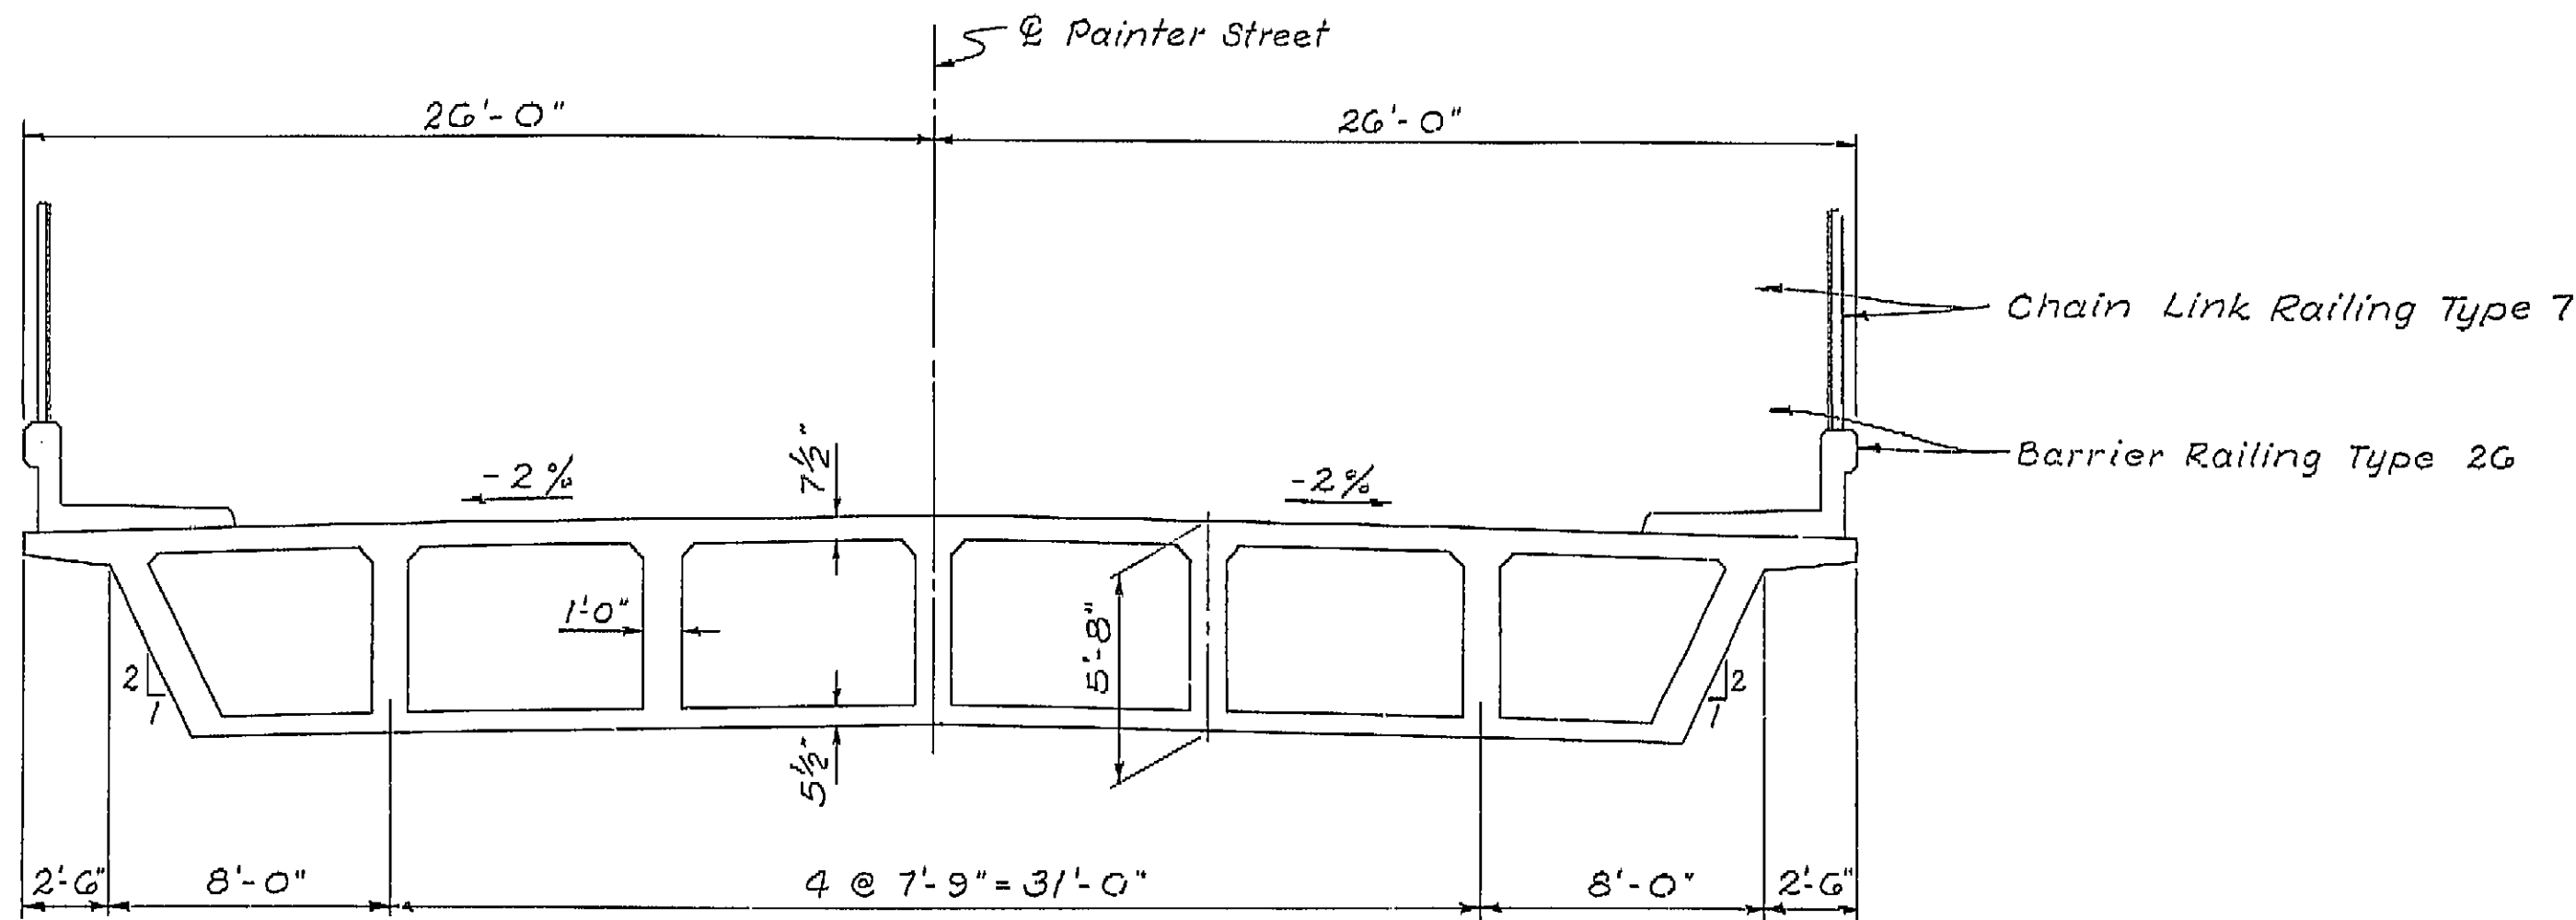

TYPICAL SECTION  
 Scale 1/4" = 1'-0"

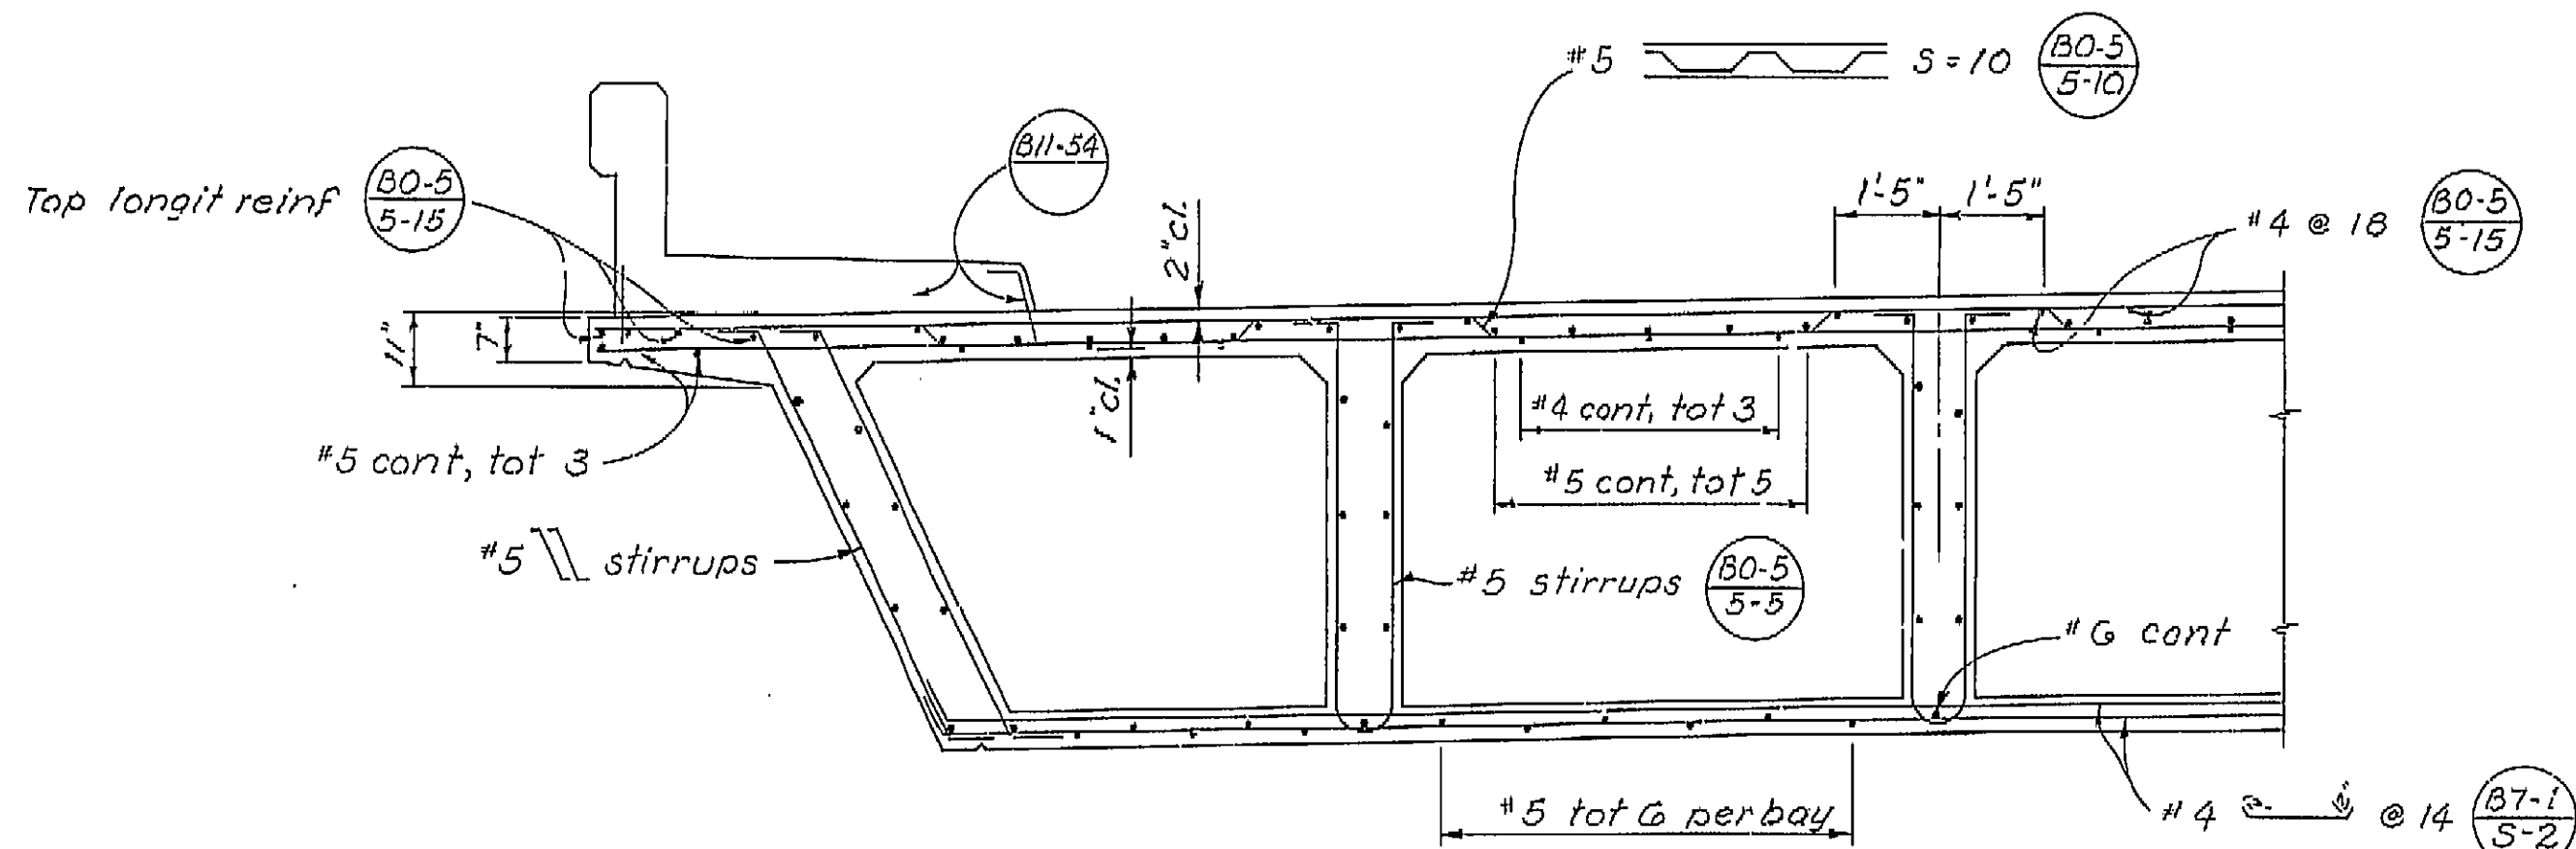

PART-SECTION (B7-1 5-1)  
 Scale 1/2" = 1'-0"


NO AS BUILT CORRECTION!  
 AS BUILT  
 CORRECTIONS BY L.A. Schroeder  
 CONTRACT NO. 01-061224  
 DATE 8-22-76 RT. 4-1-77

AS BUILT PLANS  
 Contract No. 01-061224  
 Date Completed  
 Document No. 1000-2617

BRIDGE DEPARTMENT DESIGN SECTION 6		STATE OF CALIFORNIA DEPARTMENT OF TRANSPORTATION	
Project Engineer: <i>W. Olson</i>		PAINTER STREET OVERCROSSING	
DESIGN: By <i>W. Olson</i> Checked <i>W. Olson</i>		TYPICAL SECTION	
DETAILS: By <i>R. Green</i> Checked <i>W. Olson</i>		BRIDGE NO. 4-23G	
QUANTITIES: By <i>W. Olson</i> Checked <i>R. Green</i>		POST MILE 53.2	DRAWING NO. 6 OF 10
Disregard prints bearing earlier revision dates		REVISION DATES (PRELIMINARY STAGE ONLY)	

ORIGINAL SCALE IN INCHES  
 0 1 2 3 4  
 W O  
 C U


I HEREBY CERTIFY THAT THIS IS A TRUE AND ACCURATE COPY OF THE ABOVE DOCUMENT TAKEN UNDER MY DIRECTION AND CONTROL ON THIS DATE IN SACRAMENTO, CALIFORNIA PURSUANT TO AUTHORIZATION BY THE DIRECTOR OF TRANSPORTATION.  
 DATE 1/14/77 SIGNATURE *Joseph M. Gotta* TITLE *Supervisor*

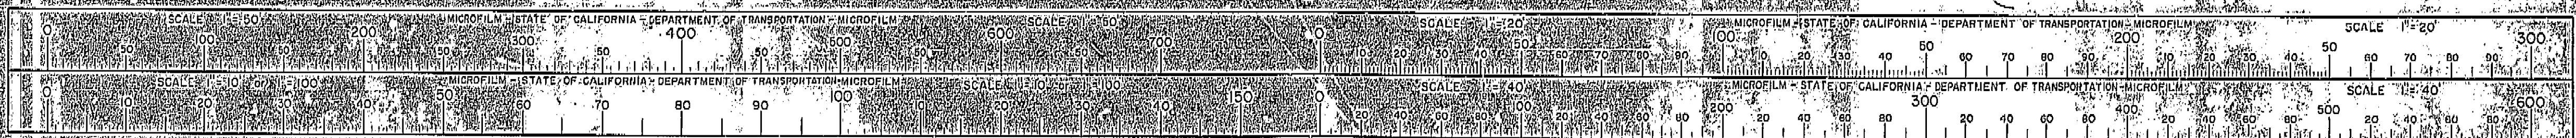




DIST.	COUNTY	ROUTE	POST MILES-TOTAL PROJECT	SHEET NO.	TOTAL SHEETS
01	Hum	101	R51.5 / R53.4	135	150


DATE APPROVED: November 19, 1973  
 REGISTERED CIVIL ENGINEER NO. 21,007

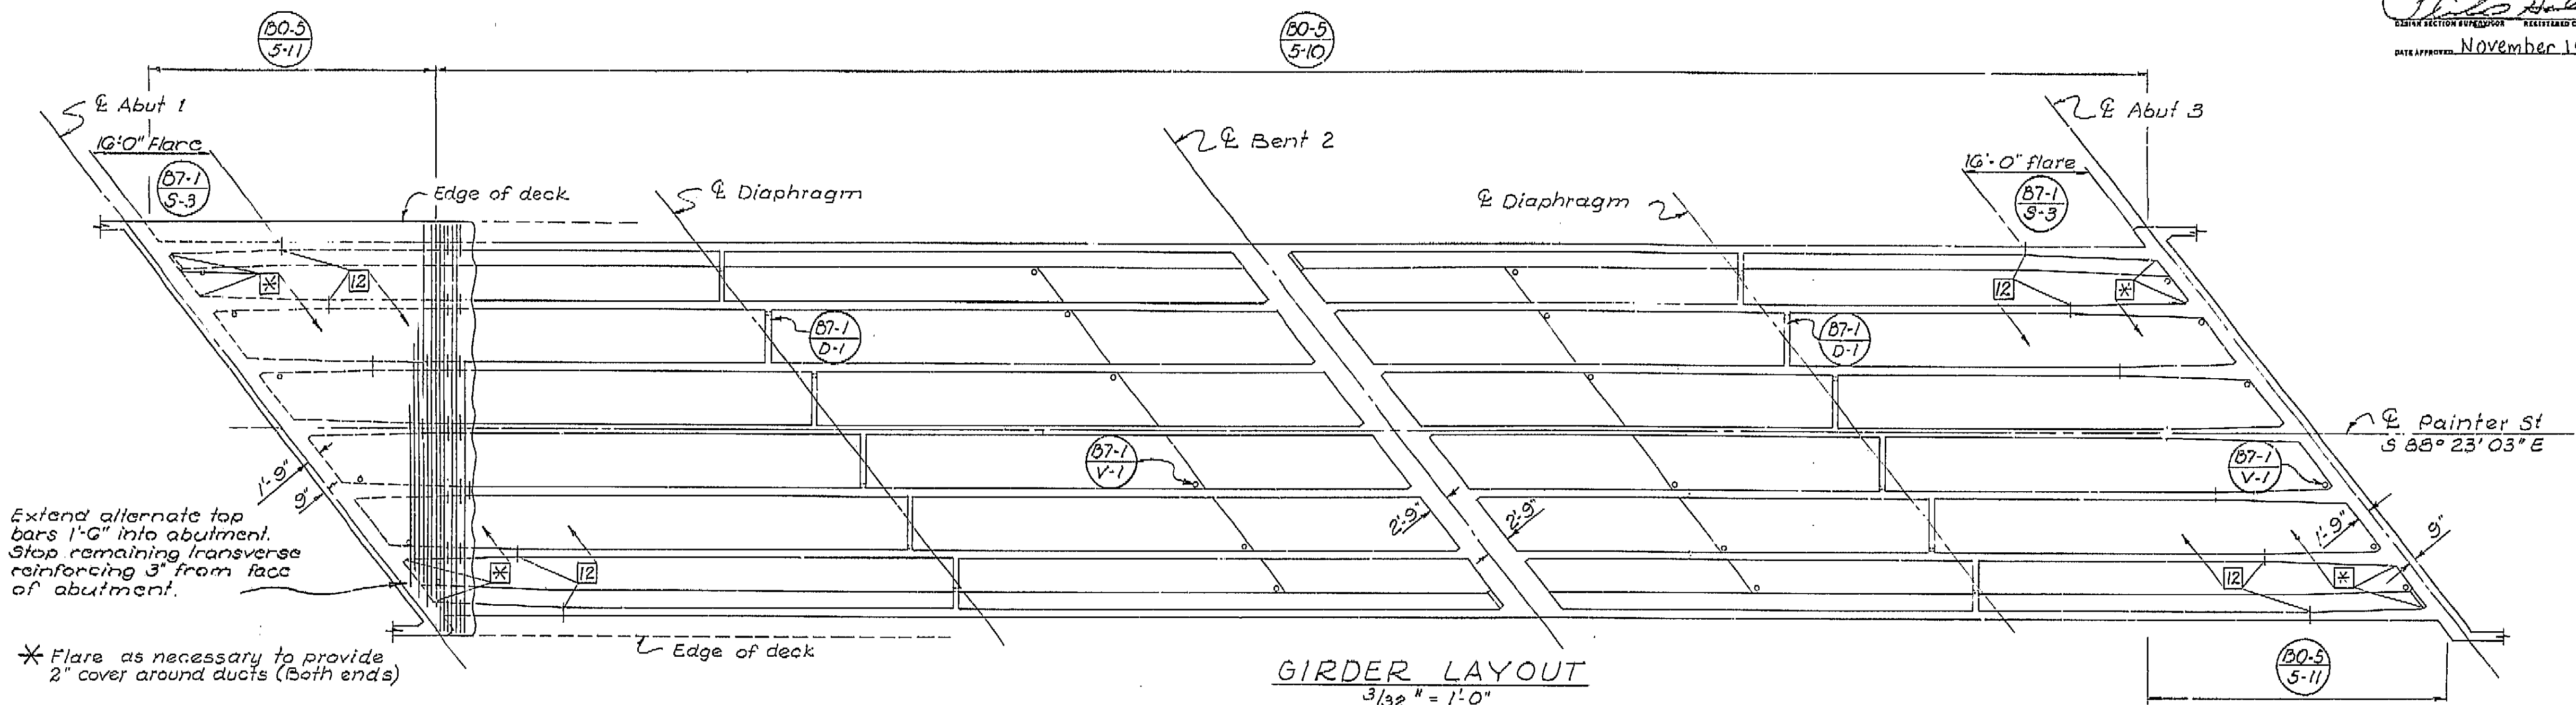


GIRDER LAYOUT  
3/32" = 1'-0"

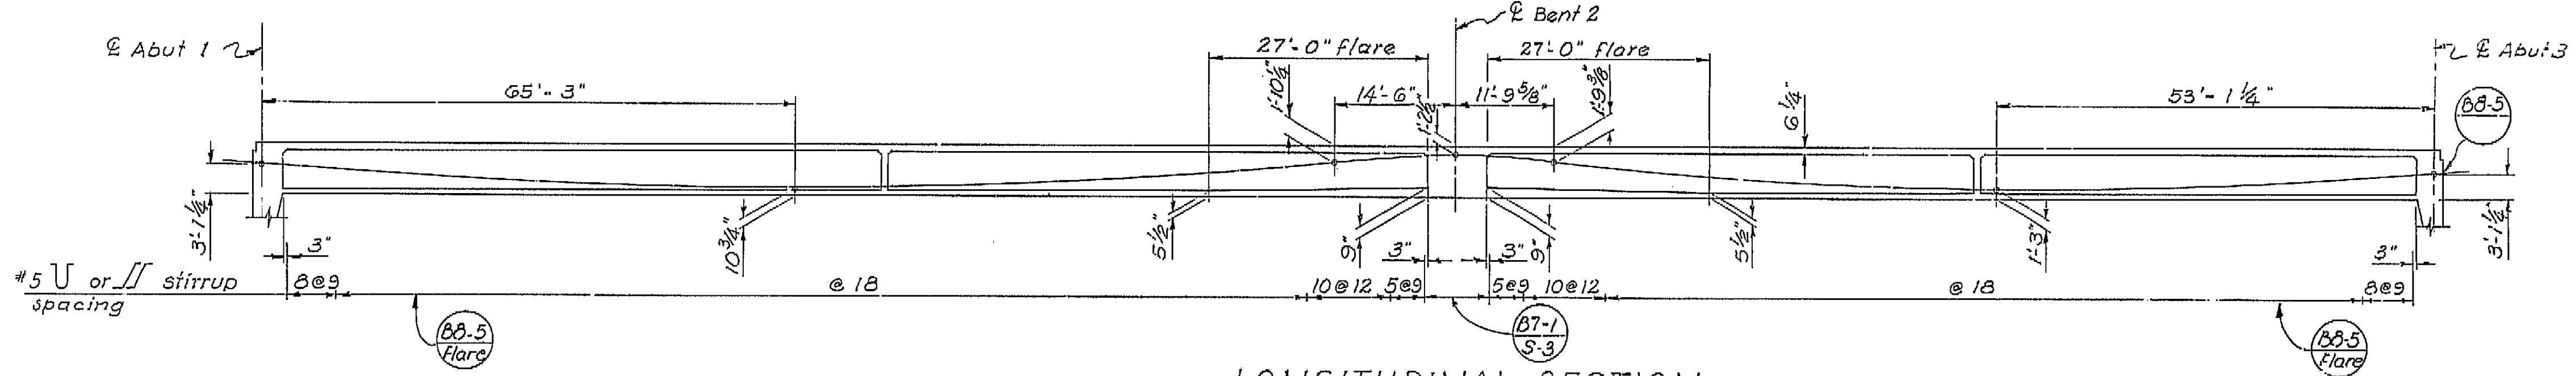

LONGITUDINAL SECTION  
3/32" = 1'-0"

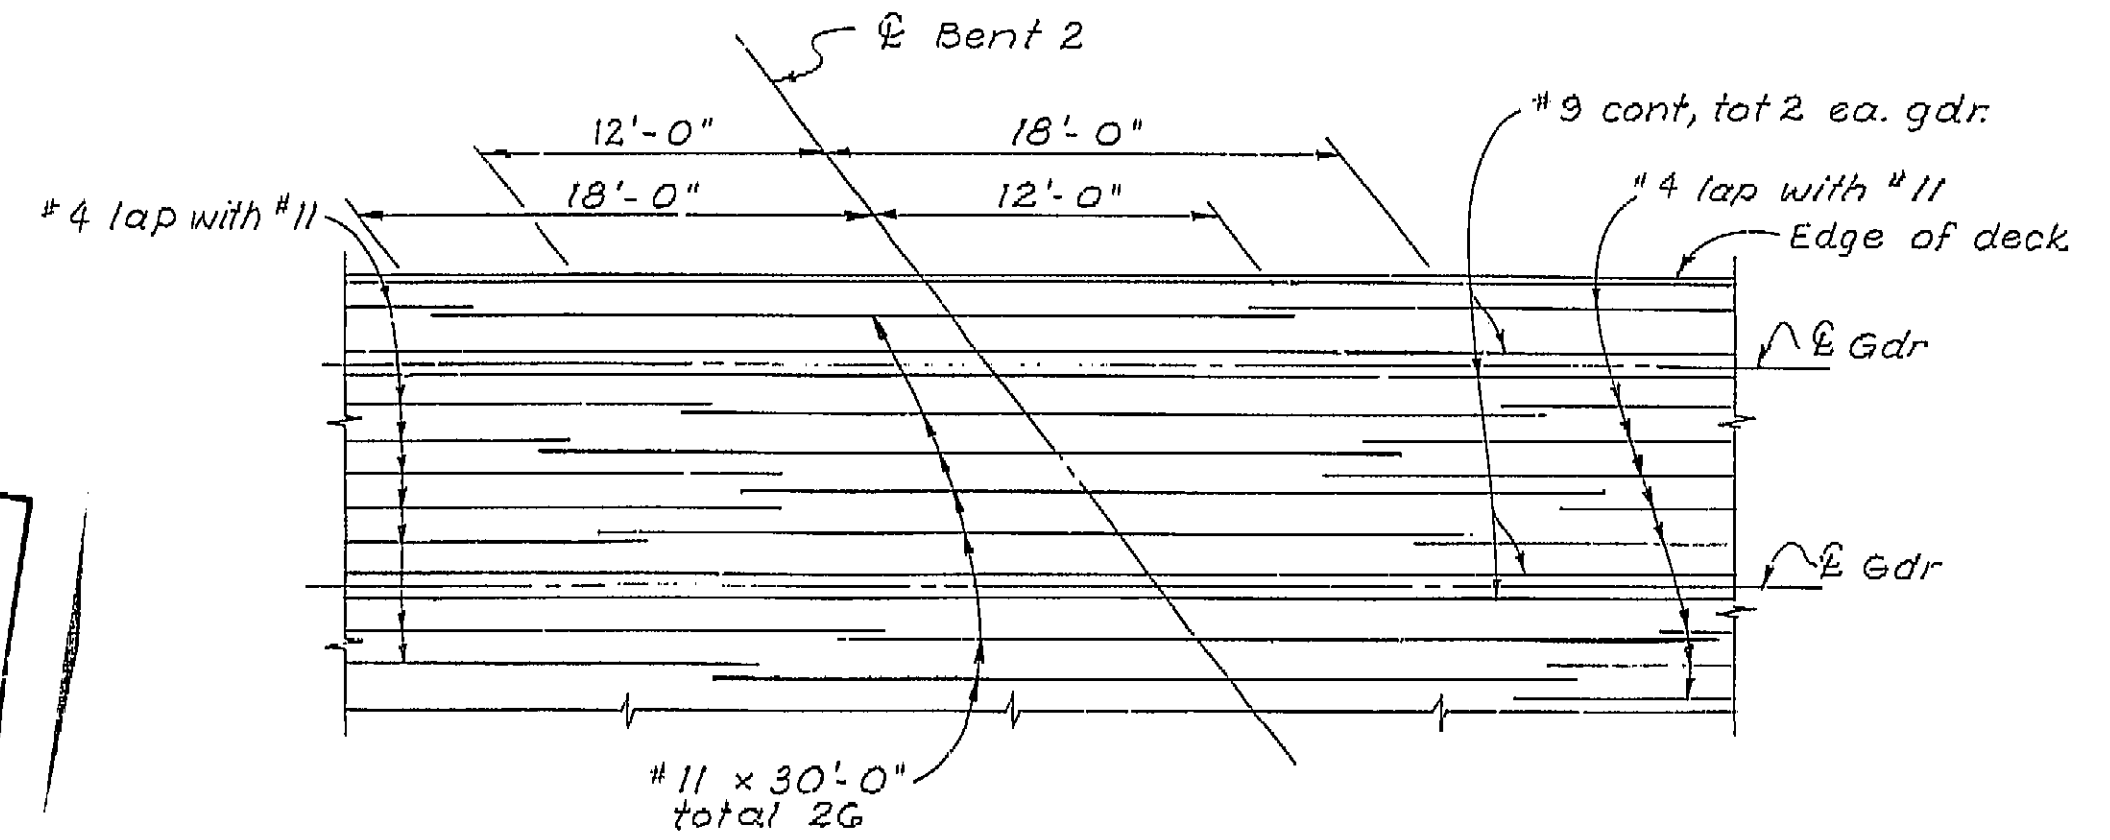

TOP LONGITUDINAL REINFORCEMENT

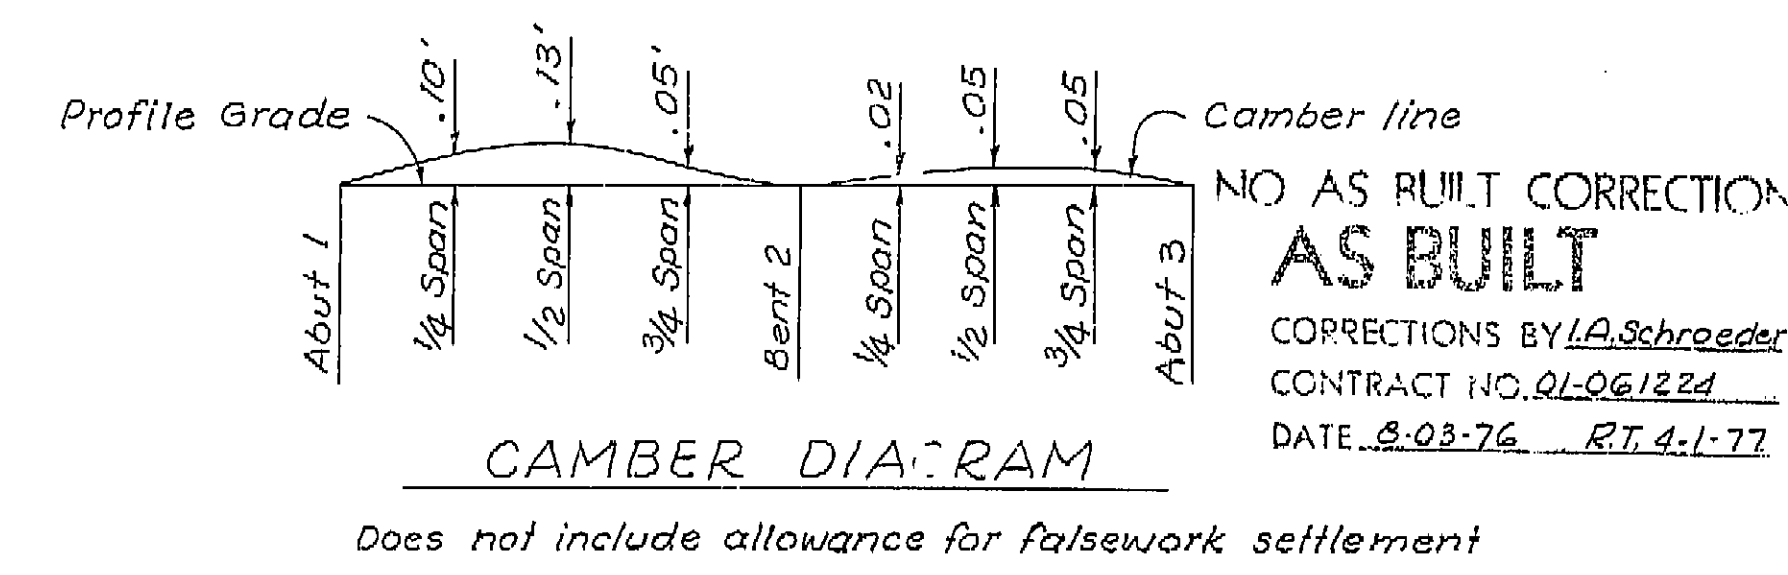


CAMBER DIAGRAM

**AS BUILT PLANS**  
 Contract No. 01-061224  
 Date Completed \_\_\_\_\_  
 Document No. 1000-2617



BRIDGE DEPARTMENT <b>DESIGN SECTION 6</b>		STATE OF CALIFORNIA DEPARTMENT OF TRANSPORTATION	
Project Engineer: <i>P. N. Green</i> Checked: <i>P. N. Green</i> Details: <i>R. Green 3/70</i> Quantities: <i>P. N. Green 9/73</i> Checked: <i>R. Green</i>		PAINTER STREET OVERCROSSING GIRDER LAYOUT BRIDGE NO. 4-230 POST MILE 53.2 DRAWING NO. 7 OF 10	
Disregard prints bearing earlier revision dates		REVISION DATES (PRELIMINARY STAGE ONLY)	

I HEREBY CERTIFY THAT THIS IS A TRUE AND ACCURATE COPY OF THE ABOVE DOCUMENT TAKEN UNDER MY DIRECTION AND CONTROL ON THIS DATE IN SACRAMENTO, CALIFORNIA PURSUANT TO AUTHORIZATION BY THE DIRECTOR OF TRANSPORTATION.  
 DATE: 4/14/77 BY: *Joseph M. Gata* TITLE: *Supervisor*

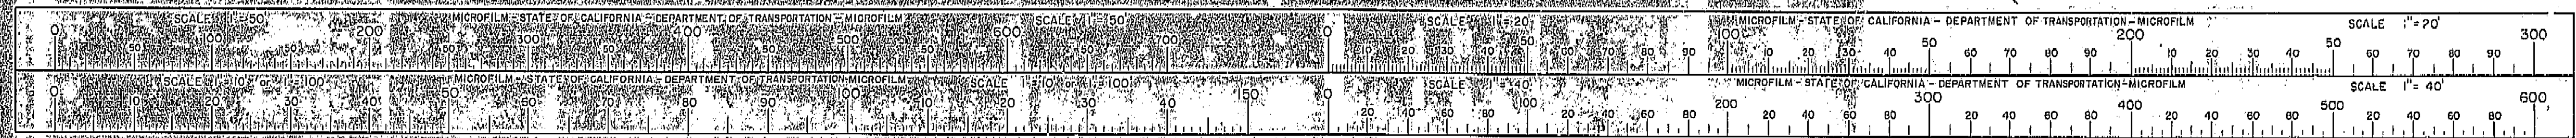




AS BUILT PLANS  
Contract No. 71-061224  
Date Completed —  
Document No. 10002617

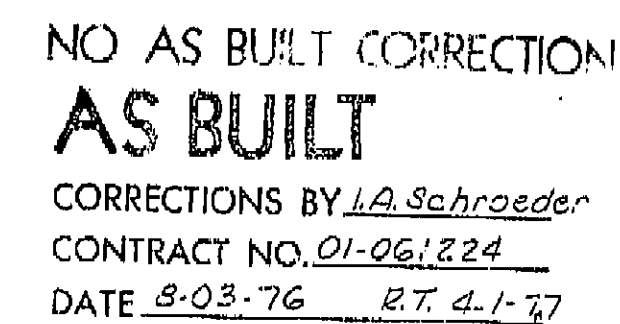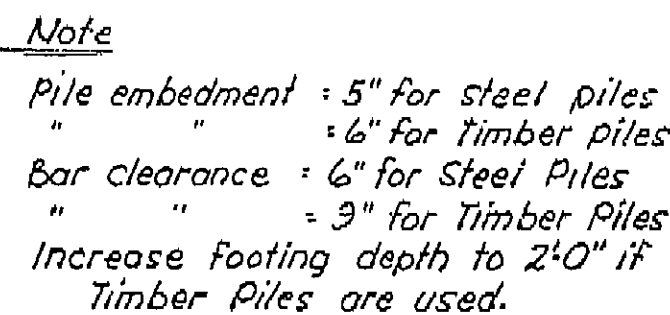

STATE OF CALIFORNIA		
DEPARTMENT OF TRANSPORTATION		XS-4-25
PAINTER STREET OVERCROSSING		
<b>SIMPLE BEAM WINGWALL DETAILS</b>		
BRIDGE NO.	POST MILE	DRAWING NO.
4-236	53.2	
		SHEET
		OF
		3 10

I HEREBY CERTIFY THAT THIS IS A TRUE AND ACCURATE COPY OF THE ABOVE DOCUMENT TAKEN UNDER MY DIRECTION AND CONTROL ON THIS DATE IN SACRAMENTO, CALIFORNIA PURSUANT TO AUTHORIZATION BY THE DIRECTOR OF TRANSPORTATION.


DATE	SIGNATURE	TITLE
4/14/77	Joseph M. Costa	Chief Person
DAB-55-76		

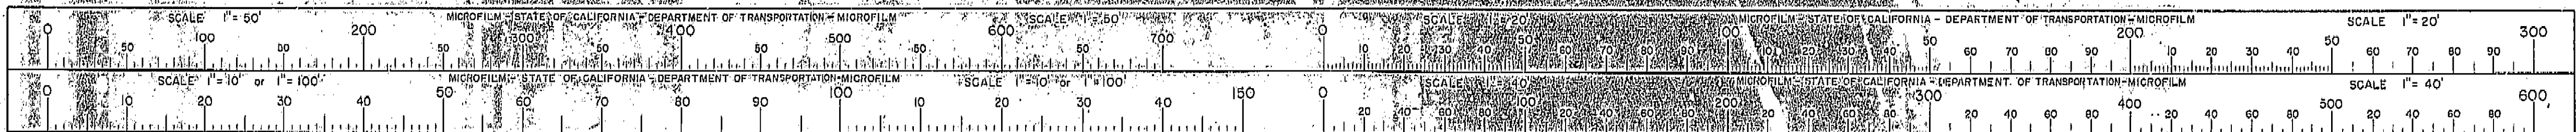









DIST	COUNTY	ROUTE	POST MILES-TOTAL PROJECT	SHEET	TOTAL
01	HUM	101	R51.5 / R53.4	137	150




BRIDGE ENGINEER  
DATE APPROVED November 19, 1973  
REGISTERED CIVIL ENGINEER No. 5505

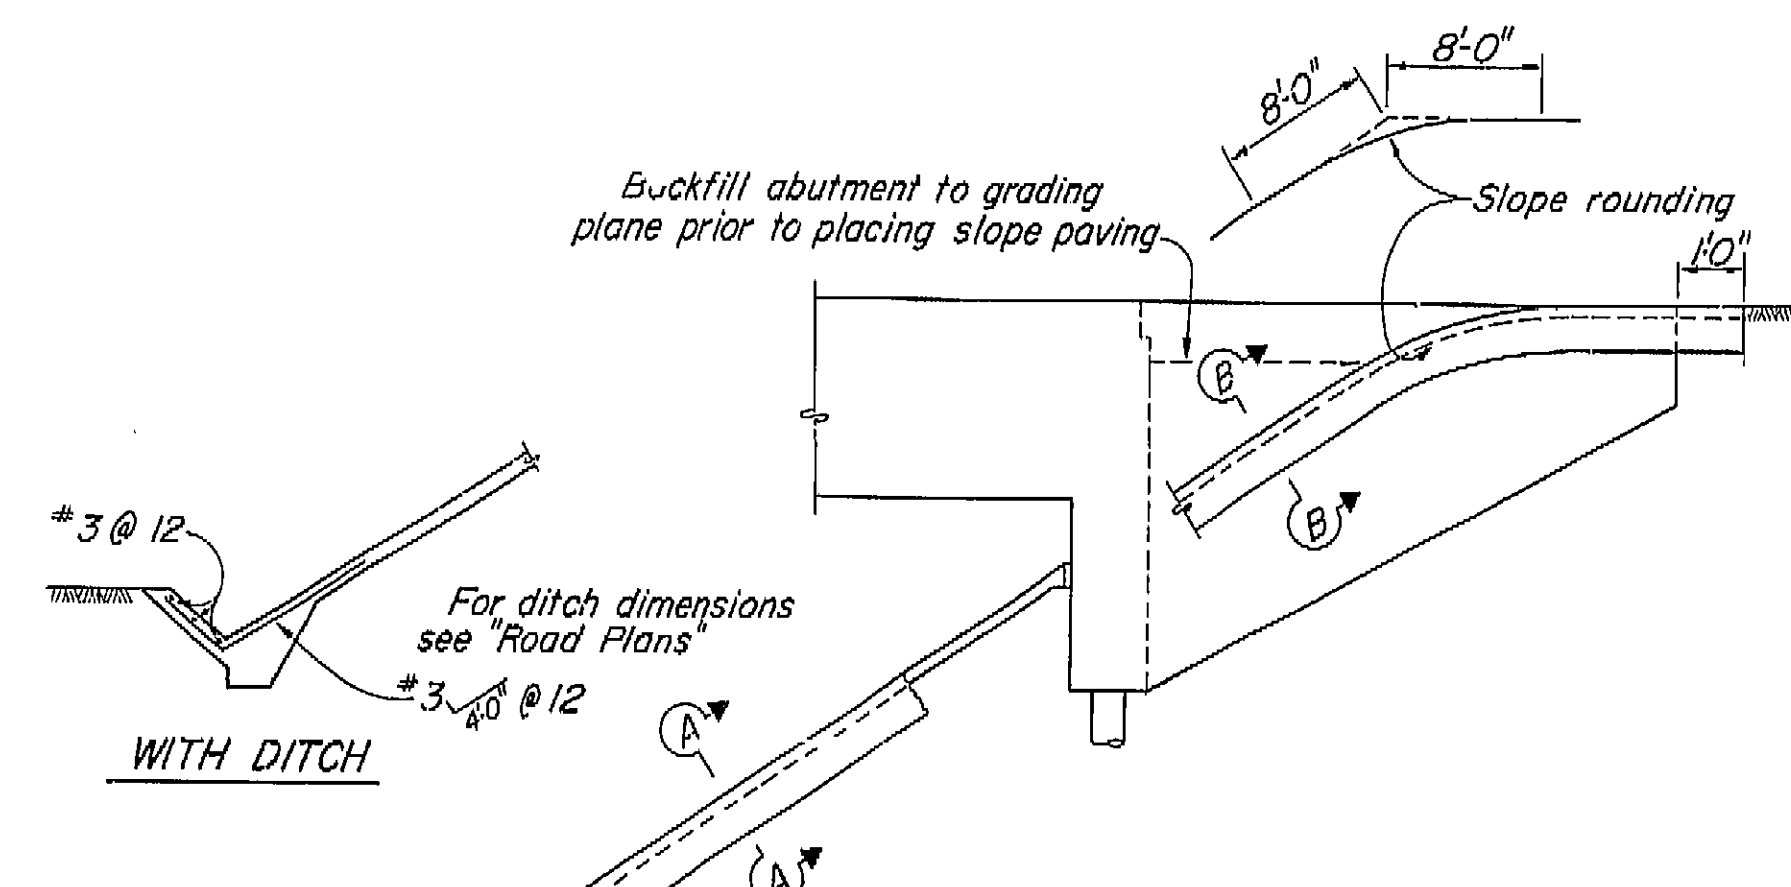

TYPICAL FULL SLOPE

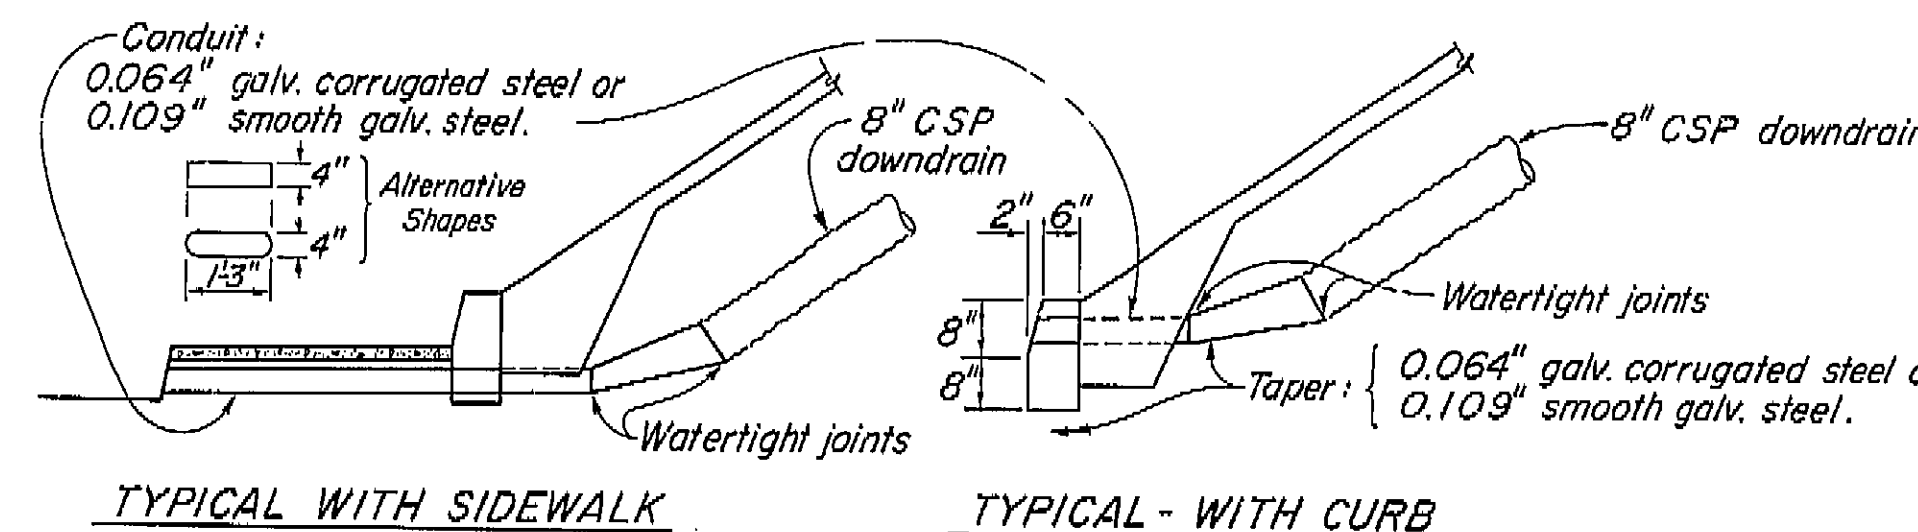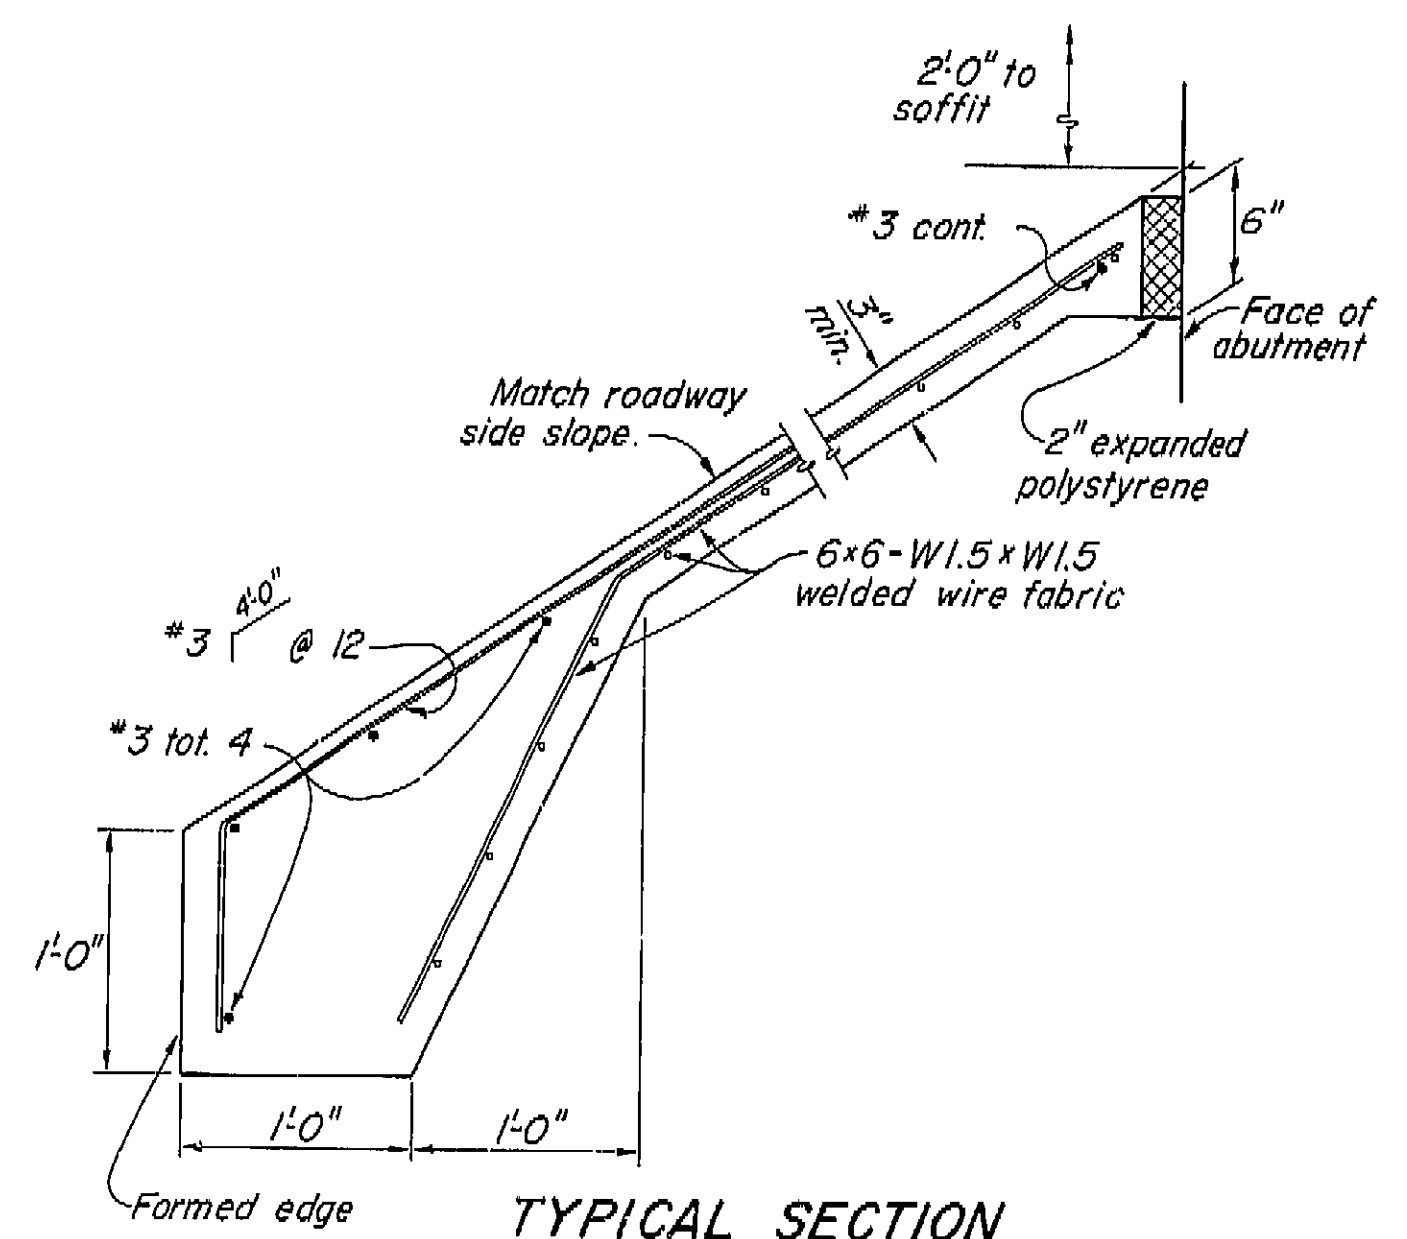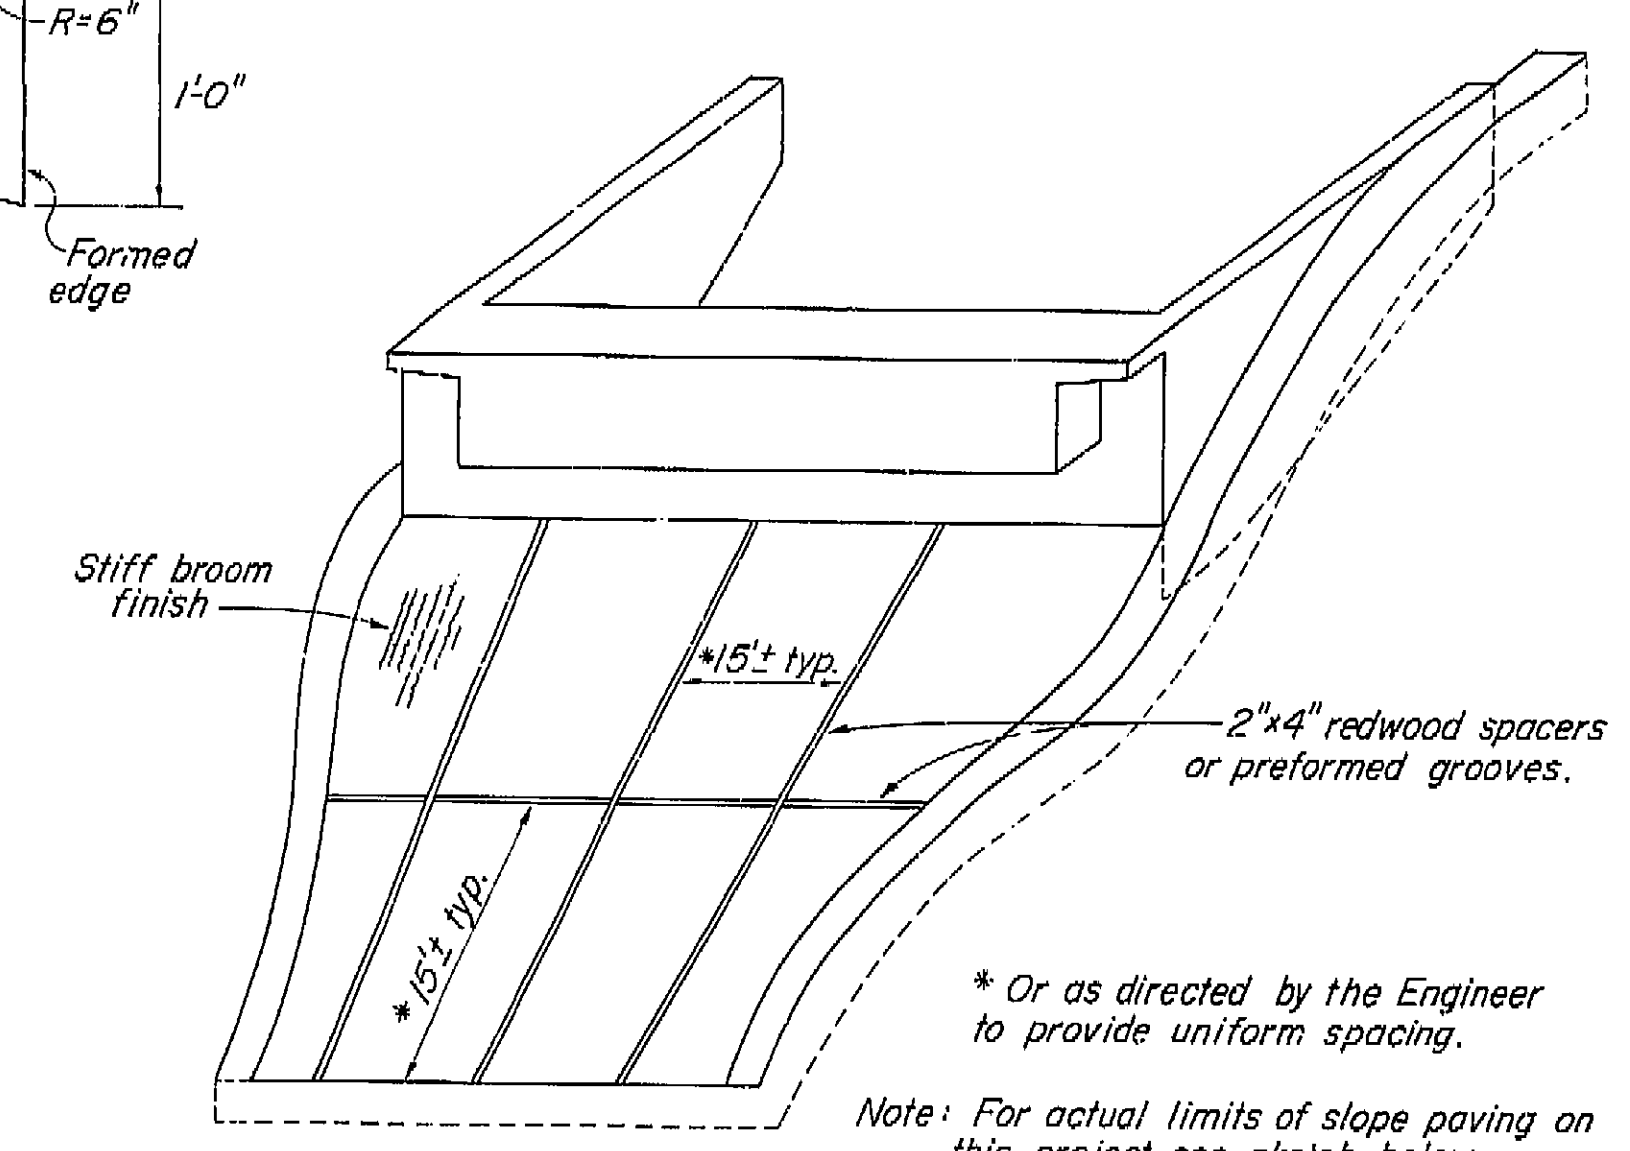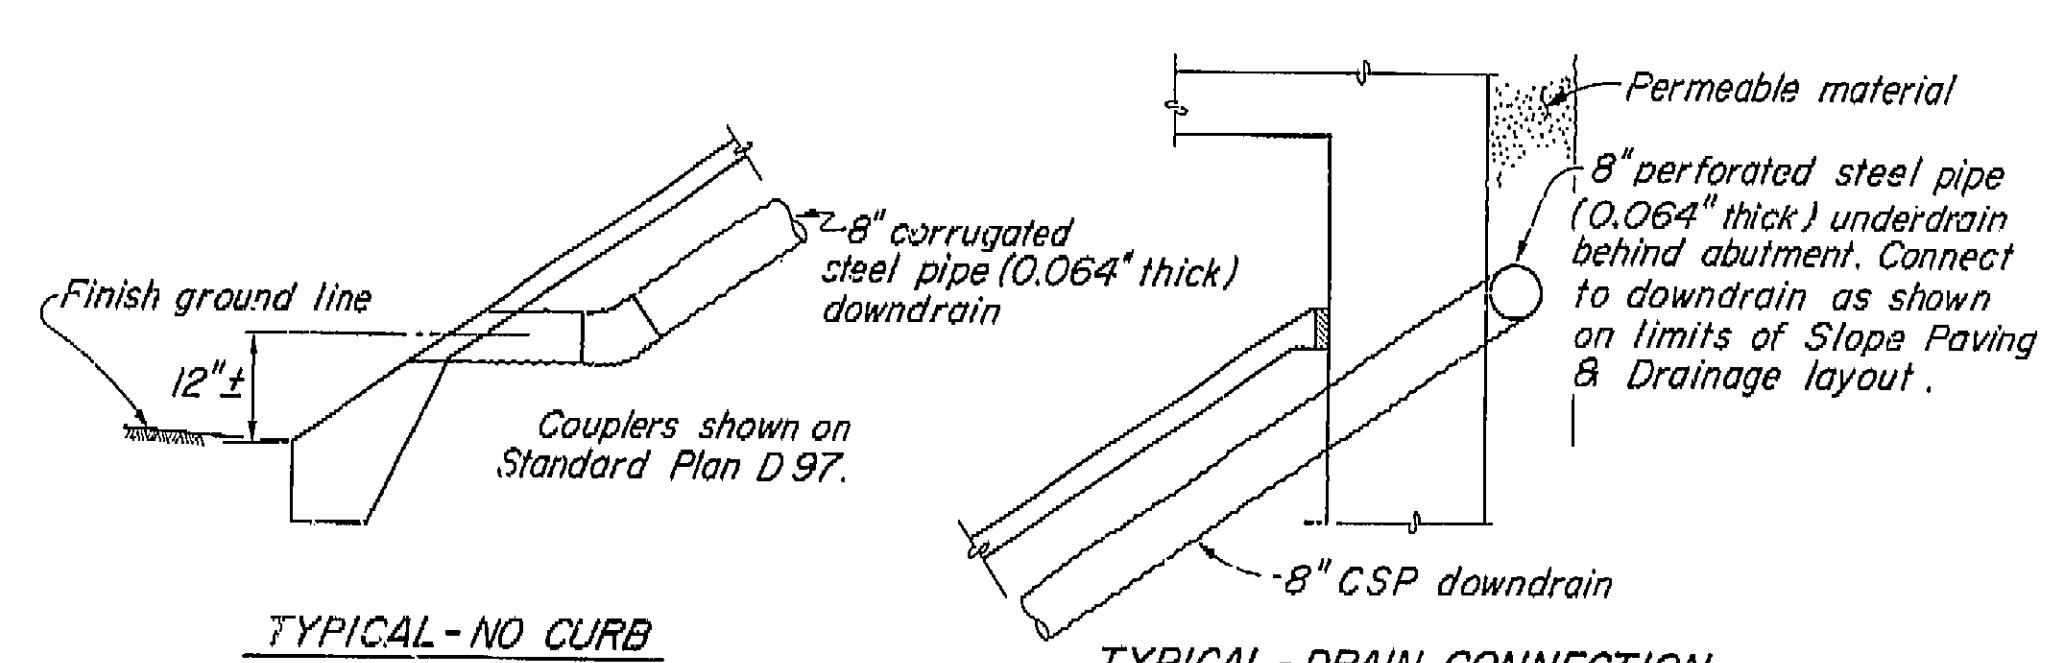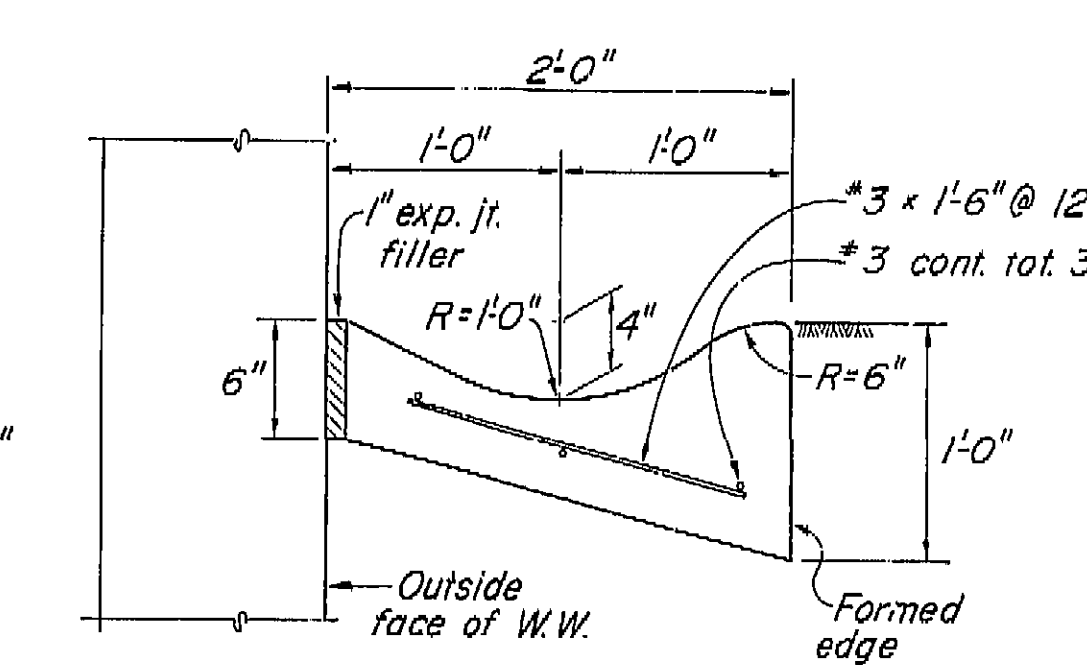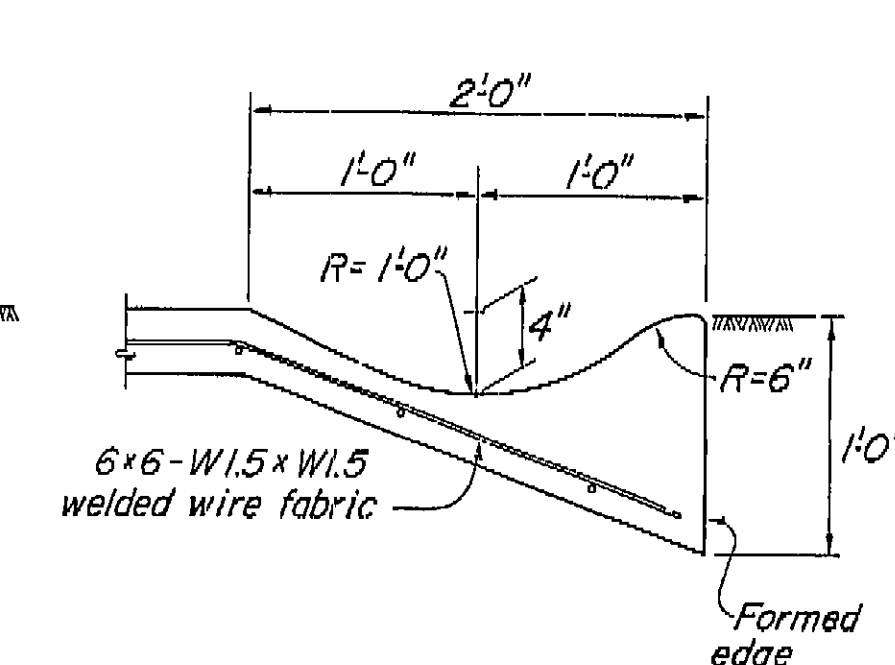

DRAINAGE DETAILS

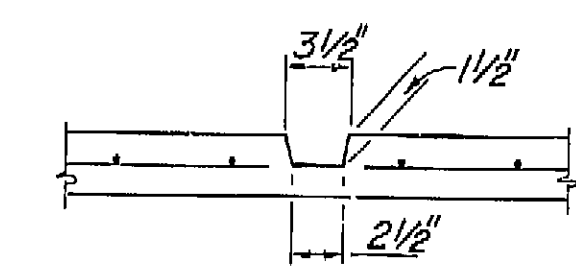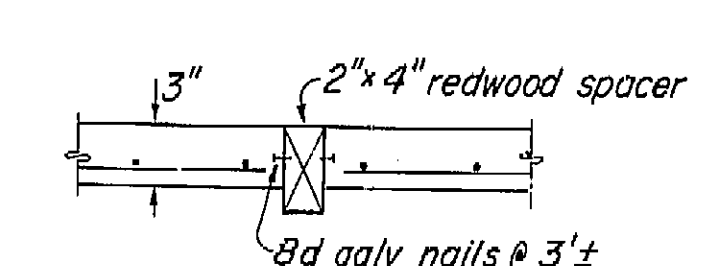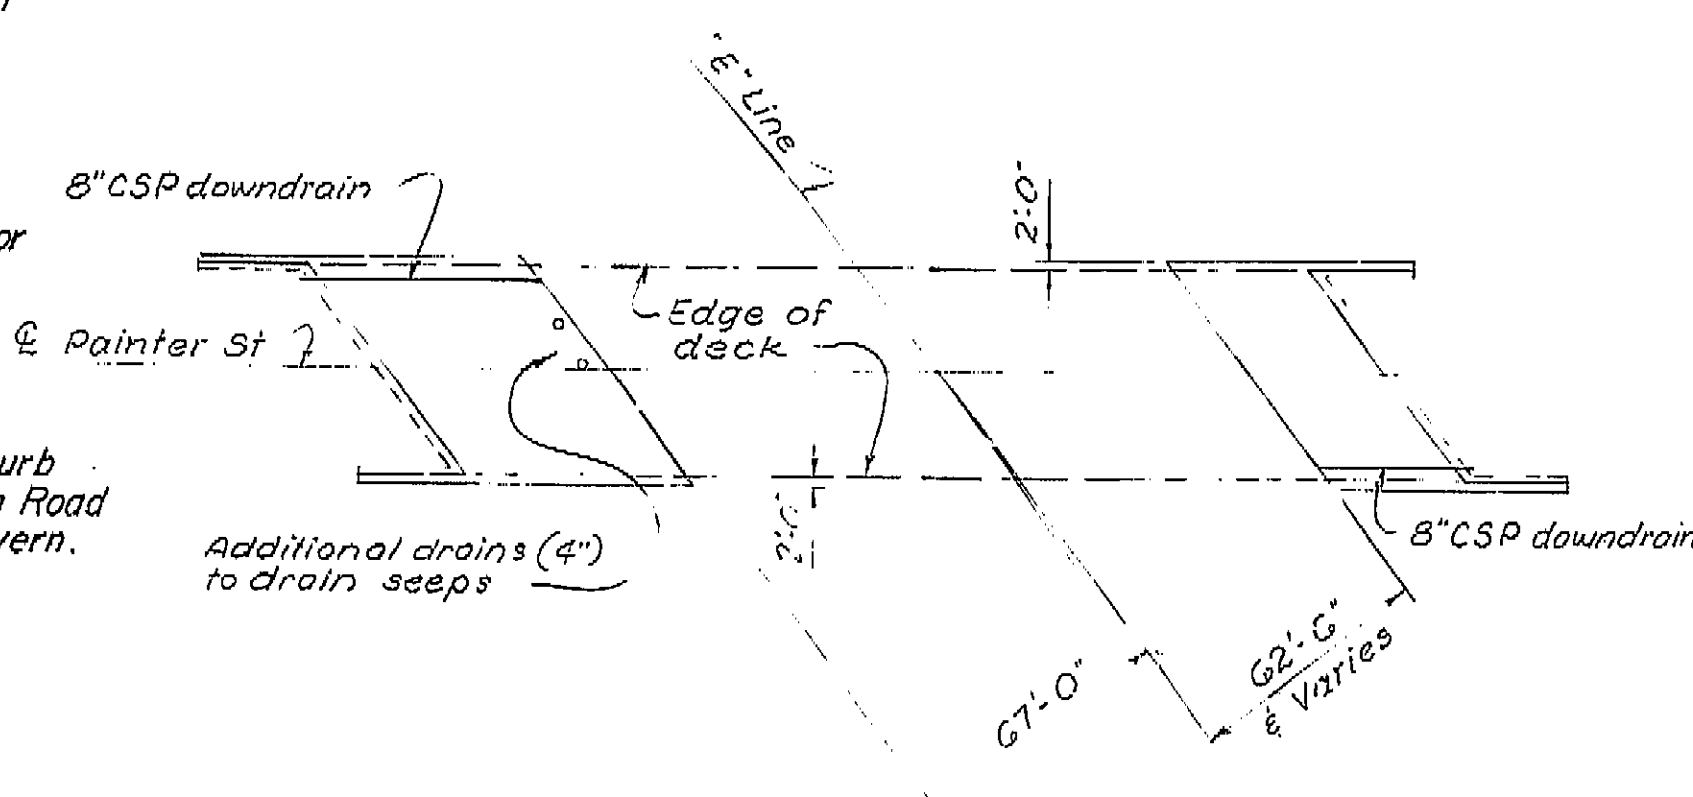


AS BUILT PLANS  
Contract No. 01-061224  
Date Completed  
Document No. 10005617

AS BUILT  
CORRECTED BY L.A. Schlegel  
CONTRACT NO. 01-061224  
DATE 8-23-76 RT. 4-1-77

STATE OF CALIFORNIA		XS-22-11	
10/72 DEPARTMENT OF TRANSPORTATION			
PAINTER STREET OVERCROSSING			
SLOPE PAVING DETAILS - FULL SLOPE			
BRIDGE NO. 4-23G	POST MILE 53.2	DRAWING NO.	SHEET 137 OF 150
REVISION DATES (PRELIMINARY STAGE ONLY)			


I HEREBY CERTIFY THAT THIS IS A TRUE AND ACCURATE COPY OF THE ABOVE DOCUMENT TAKEN UNDER MY DIRECTION AND CONTROL ON THIS DATE IN SACRAMENTO, CALIFORNIA PURSUANT TO AUTHORIZATION BY THE DIRECTOR OF TRANSPORTATION.

DATE 4/14/77 SIGNATURE Josephine G. G. TITLE Supervisor

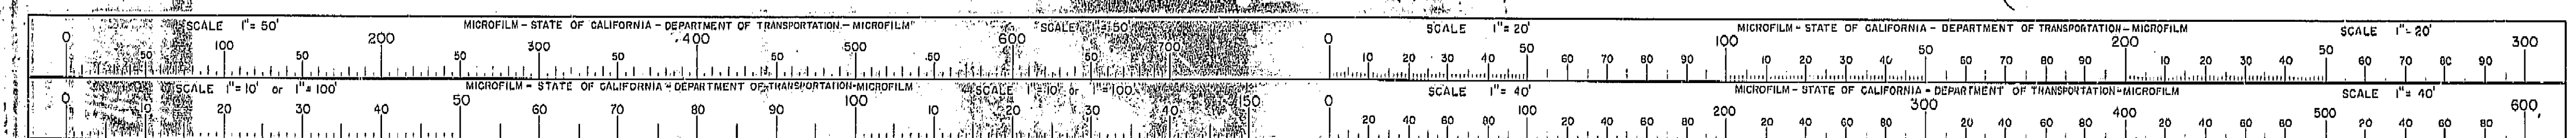




BRIDGE ENGINEER REGISTERED CIVIL ENGINEER NO. 0000  
DATE APPROVED November 19, 1973

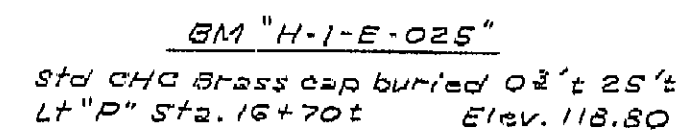

PLAN  
1" = 20'

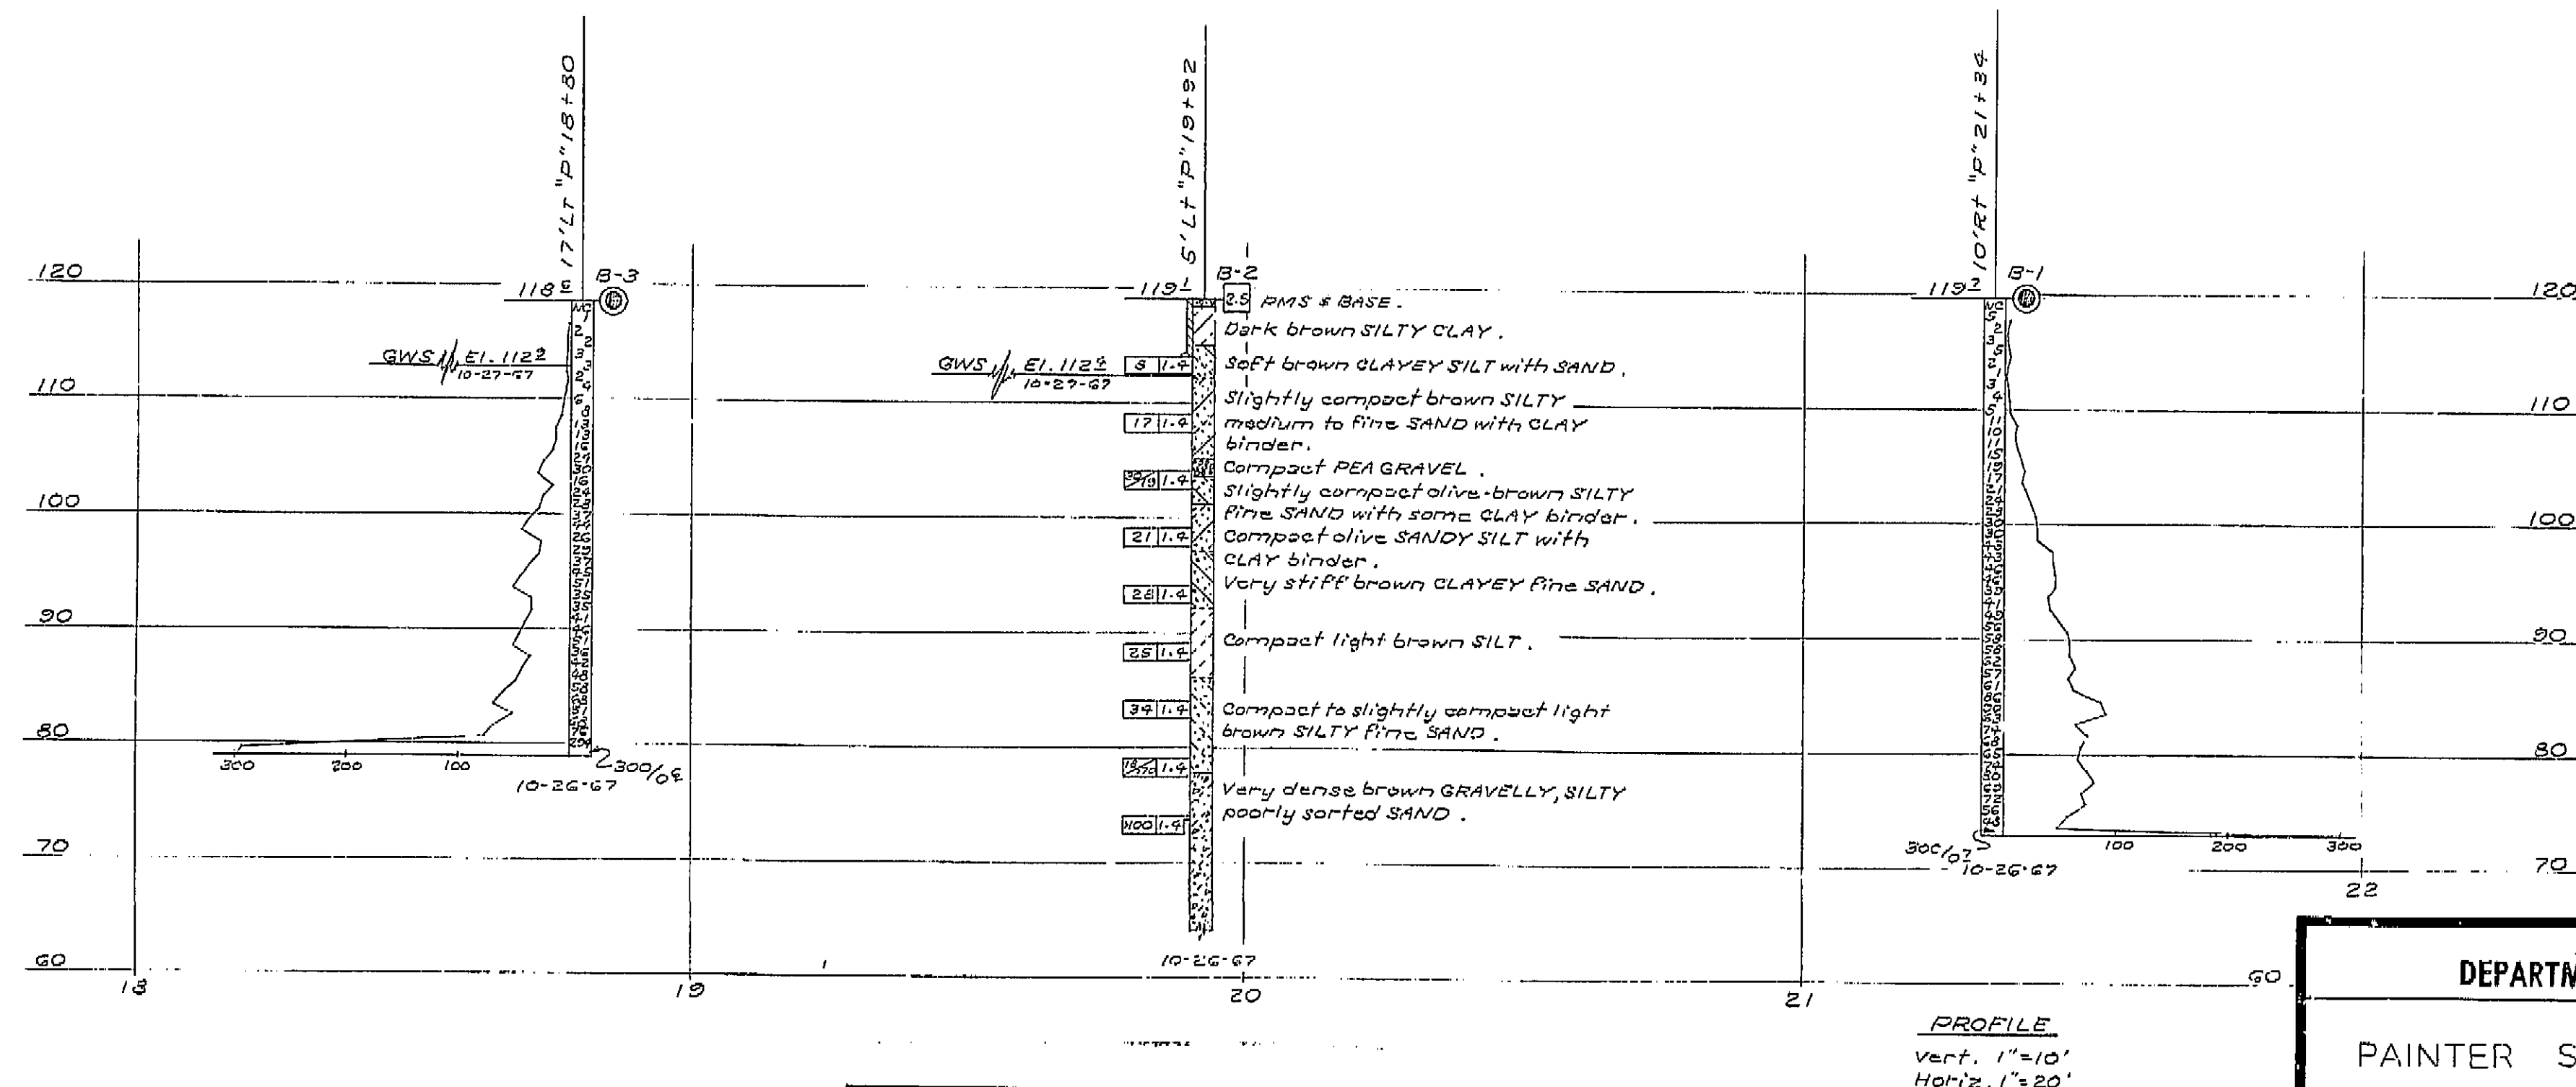

NO AS BUILT CORRECTION  
AS BUILT  
CORRECTIONS BY I.A. Schroeder  
CONTRACT NO. 01-061221  
DATE 8-03-76 R.T. 4-1-77

STATE OF CALIFORNIA  
DEPARTMENT OF TRANSPORTATION

## LOG OF TEST BORINGS

BRIDGE NO. 4-236	POST MILE 53.2	DRAWING NO.	SHEET 10	OF 10
REVISION DATES		(PRELIMINARY STAGE ONLY)		

WO 06/22/      PR-4236-2  
CU 01/20/

Disregard prints bearing earlier revision dates

	112

REVISION DATA	

YES			
-----	--	--	--

(PRELIMINARY)		
---------------	--	--




STAGE ONLY	
------------	--


١٠٠

AS BUILT PLANS  
Contract No. 01-06122-4  
Date Completed —  
Document No. 10002617


I HEREBY CERTIFY THAT THIS IS A TRUE AND ACCURATE COPY OF THE ABOVE DOCUMENT TAKEN UNDER MY DIRECTION AND CONTROL ON THIS DATE IN SACRAMENTO, CALIFORNIA PURSUANT TO AUTHORIZATION BY THE DIRECTOR OF TRANSPORTATION.

DATE 4/14/77	SIGNATURE Joseph M. Gatta	TITLE Supervisor
-----------------	------------------------------	---------------------

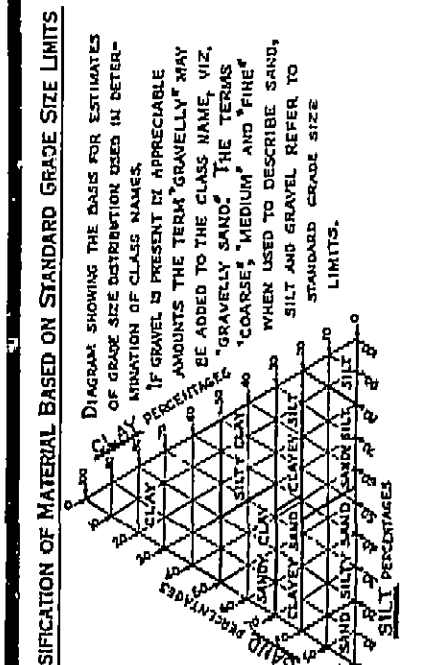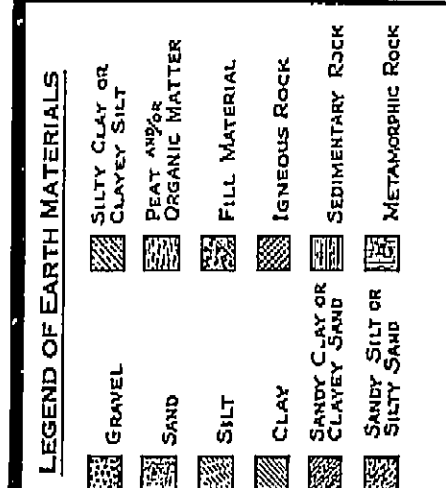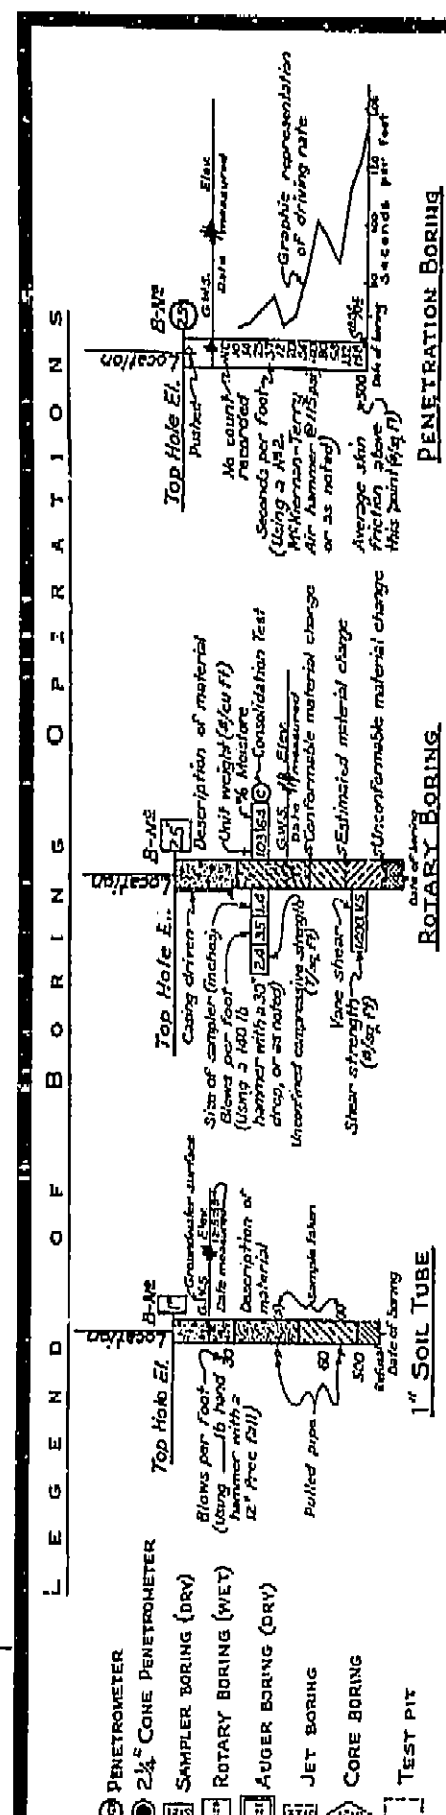

NOTE: Classification of earth material as shown on this sheet is based upon field inspection and is not to be construed to imply mechanical

FIELD STUDY	By H.E. Beeson 10-67
DRAWN	By K. Endow 11-13-67
CHECKED	By H.E. Beeson 11-19-67
Approval Recommended by <i>[Signature]</i> Engineering Geologist	



**RIDGE DEPARTMENT**  
**ENGINEERING GEOLOGY SECTION**

130

